

CODED

MISSISSIPPI
BOARD OF WATER COMMISSIONERS
416 North State Street
Jackson, Mississippi 39201

CODED

WATER WELL DRILLERS LOG

Marshall
J 16
2-69

Feb 10 1969 Bumpas Well Co Marshall
date well completed firm name county well located

LANDOWNER:

Rodger Woods
Holly Springs Miss
(mailing address)

description of formations encountered

from to

Clay 0 10
Sand 10 160

WELL LOCATION:

sec. 4 T. 3 N. R. 4 E.
1/2 miles North of Victory
(distance) (direction) (nearest town)

WELL PURPOSE:

(home, irrigation, municipal, industrial)

WELL COMPLETION DATA:

- (1) diameter (inches) 4"
- (2) total depth (feet) 160
- (3) static water level (feet) 100 below above top of ground.
- (4) casing 4" galv. 140
(material) (depth)
(size) if telescope see back.
- (5) screen 20 ft. 140
(length) (depth to top)
6" gravel well
(size) (material)
- (6) pump 5 100
(HP) (yield gpm)
Elect
(type power)

CODED

(7) electric log (yes or no)

(organization running log)


(8) how well bottom plugged 4" cap

DRILLERS REMARKS:

AUG 4 1969
MISS. BD. OF WATER COMMISSIONERS

If well telescopes please sketch and show depths.

GROUND LEVEL

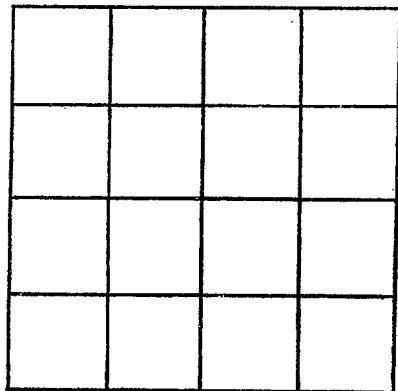

SECTION _____

Please indicate well location X.

ADDITIONAL INFORMATION

If more than one screen,
show locations of each on sketch.