

CODED

MISSISSIPPI
BOARD OF WATER COMMISSION
416 North State Street
Jackson, Mississippi 39201

CODED

Marshall
917
6-28-69

WATER WELL DRILLERS LOG

June 28 1969 Earl Jones Well Co. Marshall
date well completed firm name county well located

LANDOWNER:
R. L. Yates
Collierville Tenn. RT 2
(mailing address)

description of formations encountered	from	to
Top soil and clay	0	15
sand	15	85
clay	85	90
sand	90	126

WELL LOCATION:
sec. 11 T 3 S R. 4 E W
1.2 miles east of Victoria
(distance) (direction) (nearest town)

WELL PURPOSE: Home
(home, irrigation, municipal, industrial)

- WELL COMPLETION DATA:
- (1) diameter (inches) 2
 - (2) total depth (feet) 126
 - (3) static water level (feet) 90 below top of ground.
 - (4) casing plastic, 120 ft. (material) (depth)
(size) If telescope see back.
 - (5) screen 6 ft 120 ft (length) (depth to top)
2" plastic-gravel pack. (size) (material)
 - (6) pump 3/4 3 (HP) (yield gpm)
Electric (type power)
 - (7) electric log no (yes or no)
(organization running log)
 - (8) how well bottom plugged buckshot

CODED


JUL 30 1969

MISS. BD. OF
WATER COM. L.

DRILLERS REMARKS:

If well telescopes please sketch and show depths.

GROUND LEVEL

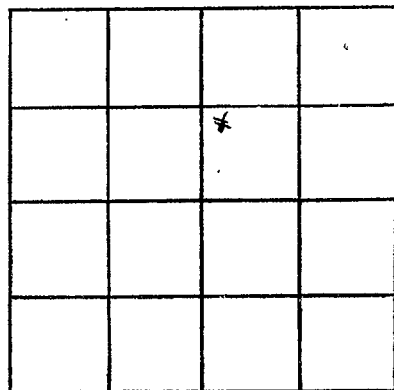

SECTION 11

Please indicate well location X.

ADDITIONAL INFORMATION

If more than one screen, show locations of each on sketch.