

CODED

MISSISSIPPI
BOARD OF WATER COMMISSIONERS
416 North State Street
Jackson, Mississippi 39201

CODED

WATER WELL DRILLERS LOG

Marshall
8 18
7-16-69

July 16 1969 date well completed
Earl Jones Well Co. firm name
Marshall county well located

LANDOWNER:

Fred Barnes

description of formations encountered

from to

Byhalia Miss. RT 2.
(mailing address)

sand 0 90
clay 90 95
sand 95 158

WELL LOCATION:

sec 16 T 3 N R 4 E
1 1/4 miles S.W. of Victoria
(distance) (direction) (nearest town)

WELL PURPOSE: Home
(home, irrigation, municipal, industrial)

WELL COMPLETION DATA:

- (1) diameter (inches) 2"
- (2) total depth (feet) 158 ft.
- (3) static water level (feet) 94 below top of ground.
- (4) casing plastic 152 ft.
(material) (depth)
- (size) If telescope see back.
- (5) screen 6 ft 152 ft.
(length) (depth to top)
- 2" plastic-gravel
(size) (material)
- (6) pump 1 3 1/2
(HP) (yield gpm)
- Electric
(type power)
- (7) electric log no.
(yes or no)

CODED

JUL 30 1969

MISS. Bd. OF
WATER COMM.


(organization running log)

(8) how well bottom plugged Buckshot

DRILLERS REMARKS:

If well telescopes please sketch and show depths.

GROUND LEVEL

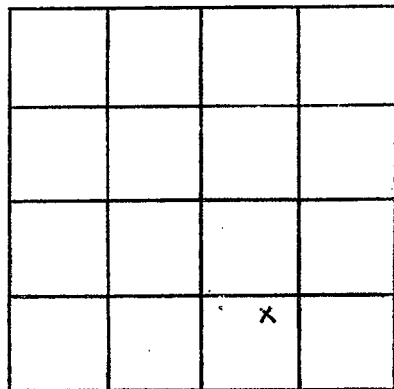

SECTION 16

Please indicate well location X.

ADDITIONAL INFORMATION

If more than one screen, show locations of each on sketch.