

CODED

*Revised*

CODED

MISSISSIPPI  
BOARD OF WATER COMMISSIONERS  
416 North State Street  
Jackson, Mississippi 39201

CODED

WATER WELL DRILLERS LOG

Marshall  
J 19,  
10-22-69

Oct. 22 1969  
date well completed

W.C. Mason  
firm name

Marshall  
county well located

LANDOWNER:	description of formations encountered	from	to
<u>Earnest Turner</u> <u>Rt. 2</u> <u>Bohemia Miss.</u> (mailing address)			
WELL LOCATION:			
sec. <u>7</u> T. <u>3</u> N. R. <u>4</u> E. <u>SW</u> <u>2 1/2</u> miles <u>SW</u> of <u>Victoria</u> (distance) (direction) (nearest town)			
WELL PURPOSE: <u>Home</u> (home, irrigation, municipal, industrial)			
WELL COMPLETION DATA:			
(1) diameter (inches) <u>4</u>			
(2) total depth (feet) <u>40</u>			
(3) static water level (feet) <u>30</u> below top of ground. above			
(4) casing <u>stone plastic</u> <u>40'</u> (material) (depth)			
<u>4"</u> (size) if telescope see back.			
(5) screen <u>none</u> (length) (depth to top)			
<u>none</u> (size) (material)			
(6) pump <u>none</u> (HP) (yield gpm)			
(type power)			
(7) electric log <u>none</u> (yes or no)			
(organization running log)			
(8) how well bottom plugged <u>not</u>			
DRILLERS REMARKS:			


CODED

OCT 24 1969

MISS. BD. OF  
WATER COMM.

If well telescopes please sketch and show depths.

GROUND LEVEL

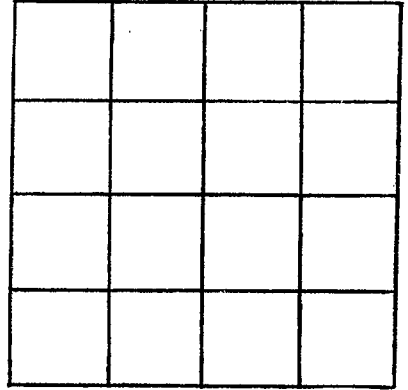

SECTION 7

Please indicate well location X.

ADDITIONAL INFORMATION

*put 4" AI - casing  
inside of square  
cush every made  
by Jeffers Jovan  
about 30 yrs ago*

If more than one screen,  
show locations of each on sketch.