

Marshall Co
 J 20
 5-69

MISSISSIPPI
 BOARD OF WATER COMMISSIONERS
 416 North State Street
 Jackson, Mississippi 39201

CODED

CODED

WATER WELL DRILLERS LOG

5-20 1969 Bob Smith Marshall
 date well completed firm name county well located

LANDOWNER: M^c Nish
 Victoria, Miss.
 (mailing address)

description of formations encountered	from	to
red clay	8	10
red sand	10	40
white clay	40	50
white sand	50	125

WELL LOCATION:
 sec. 36 T. 3 N. R. 4 E
 7 miles (distance) S (direction) of Victoria (nearest town)

WELL PURPOSE: Home
 (home, irrigation, municipal, industrial)

WELL COMPLETION DATA:

(1) diameter (inches) 4

(2) total depth (feet) 125

(3) static water level (feet) 100 below top of ground.

(4) casing 4" (size) Plastic (material) 125 (depth)

_____ If telescope see back. (size)

(5) screen 20 (length) 105 (depth to top)

4" (size) Plastic (material)

(6) pump 3/4 (HP) 15 (yield gpm)

Electric (type power)

(7) electric log 74 (yes or no)

_____ (organization running log)

(8) how well bottom plugged slugged


CODED

AUG 11 1969
 MISS. DIV. OF
 WATER CONTROL

DRILLERS REMARKS:
 good drilling

If well telescopes please sketch and show depths.

GROUND LEVEL

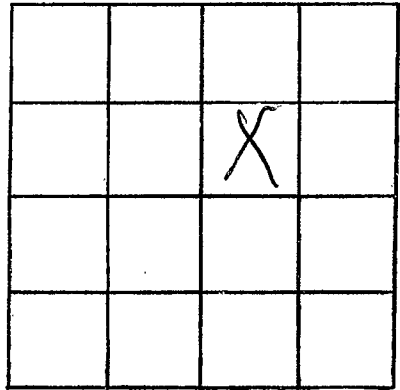

SECTION 36

Please indicate well location X.

ADDITIONAL INFORMATION

If more than one screen,
show locations of each or sketch.