

CODED

MISSISSIPPI
BOARD OF WATER COMMISSIONERS
416 North State Street
Jackson, Mississippi 39201

CODED

WATER WELL DRILLERS LOG

Marshall
J 21
8-13-69

Aug 13 1969 day well completed
Earl Jones Well Co. firm name
Marshall county well located

LANDOWNER:

John Walsh

VICTORIA MISS
(mailing address)

WELL LOCATION:

sec. 11 T 3 N R 4 E
S W
1 miles east of VICTORIA
(distance) (direction) (nearest town)

WELL PURPOSE: HOME
(home, irrigation, municipal, industrial)

WELL COMPLETION DATA:

- (1) diameter (inches) 2"
- (2) total depth (feet) 148
- (3) static water level (feet) 90 below top of ground.
- (4) casing plastic, 142' (material) (depth)
(size) if telescope see back.
- (5) screen 6 ft, 142 (length) (depth to top)
2" plastic-gravel (size) (material)
- (6) pump 3/4 HP, 3 (yield gpm)
Electric (type power)
- (7) electric log no (yes or no)

(organization running log)

(8) how well bottom plugged Buckshot

description of formations encountered

from to

| | | |
|-----------------|----|-----|
| Top soil + clay | 0 | 15 |
| sand | 15 | 80 |
| clay | 80 | 84 |
| sand | 84 | 148 |

CODED


DRILLERS REMARKS:

REC 15 1969

MISS. BD. OF
WATER COMMISSIONERS

If well telescopes please sketch and show depths.

GROUND LEVEL

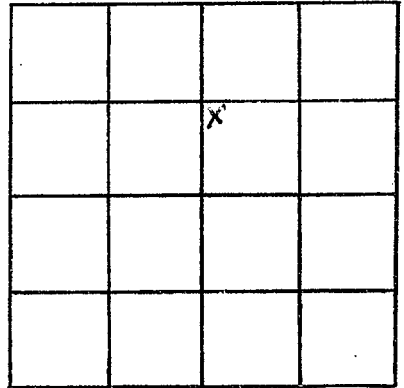

SECTION 11

Please indicate well location X.

ADDITIONAL INFORMATION

If more than one screen, show locations of each on sketch.