

CODED

MISSISSIPPI
BOARD OF WATER COMMISSIONERS
416 North State Street
Jackson, Mississippi 39201

WATER WELL DRILLERS LOG

CODED

Marshall
J 22
8-16-69

Aug 16 1969
dry well completed

Earl Jones Well Co.
firm name

Marshall
county well located

LANDOWNER: Fred Hensley

description of formations encountered

from

to

Holly Springs Miss.
(mailing address)

Top soil and clay
sand
clay and shale
sand

0 17
17 105
105 135
135 166

WELL LOCATION:

sec. 3 T. 3 N. R. 4 E
S W
1/2 miles east of VICTORIA
(distance) (direction) (nearest town)

WELL PURPOSE: Home
(home, irrigation, municipal, industrial)

WELL COMPLETION DATA:

- (1) diameter (inches) 2"
- (2) total depth (feet) 166
- (3) static water level (feet) 80 below top of ground.
- (4) casing plastic 160 (material) (depth)
- (size) If telescope see back.
- (5) screen 6 ft 160 (length) (depth to top)
- 2" plastic gravel (size) (material)
- (6) pump 3/4 4 (HP) (yield gpm)
- Electric (type power)
- (7) electric log no. (yes or no)

CODED

(organization running log)

(8) how well bottom plugged Buckshot


DRILLERS REMARKS:

SEP 15 1969

MISS. BD. OF
WATER COMM.

If well telescopes please sketch and show depths.

GROUND LEVEL

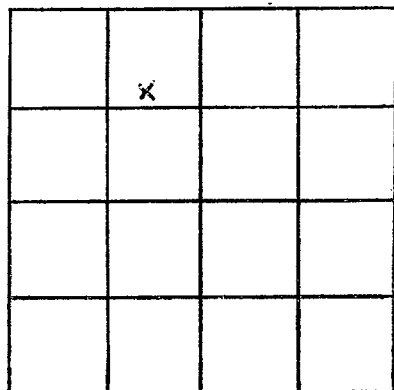

SECTION 3

Please indicate well location X.

ADDITIONAL INFORMATION

If more than one screen, show locations of each on sketch.