

CODED

Marshall
J 24
11-11-69

MISSISSIPPI
BOARD OF WATER COMMISSIONERS
416 North State Street
Jackson, Mississippi 39201

Reard

CODED

WATER WELL DRILLERS LOG

W. G. Mason water well

Post master
Marshall

Nov. 17th 1969
date well completed

firm name

county well located


LANDOWNER:	description of formations encountered	from	to
George Davis Rt. 3 - Byhalia Miss. 3861 (mailing address)	Coarse white water bearing sand	92	75
WELL LOCATION: sec 29 T 3 N R 4 E 3 miles EAST of Watson (distance) (direction) (nearest town)			
WELL PURPOSE: Home (home, irrigation, municipal, industrial)			
WELL COMPLETION DATA: (1) diameter (inches) 4" (2) total depth (feet) 75 (3) static water level (feet) 65 below top of ground. (4) casing PVC Plastic 75' (material), (depth) 4" (size) if telescope see back. (5) screen none (length), (depth to top) (size) (material) (6) pump none (HP) (yield gpm) (type power) (7) electric log (yes or no) (organization running log) (8) how well bottom plugged not			
DRILLERS REMARKS:			

DEC - 1 1969

MISS. DE
CODED

If well telescopes please
sketch and show depths.

GROUND LEVEL

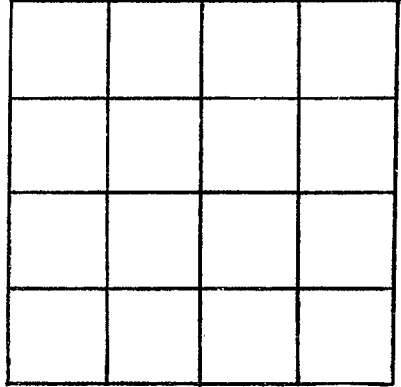

SECTION _____

Please indicate well location X.

ADDITIONAL INFORMATION

Rechecked old square
wood cask well
made by Frank
Shipp in 1960

If more than one screen,
show locations of each on sketch.