

MISSISSIPPI  
BOARD OF WATER COMMISSIONERS  
416 North State Street  
Jackson, Mississippi 39201

**CODED**

WATER WELL DRILLERS LOG

Marshall  
J 27  
3-5-70

March 5 1970 Earl Jones Well Co Marshall  
date well completed firm name county well located

LANDOWNER:  
Melvin Shaleford  
Byholio mess  
(mailing address)

description of formations encountered	from to	
Topsoil & clay	0	15
sand rock	15	19
sand	19	75
clay	75	80
sand	80	105
clay	105	115
sand	115	168

WELL LOCATION:  
sec. 29 T 2 N R 4 E  
5 miles Northw. of Victoria  
(distance) (direction) (nearest town)

WELL PURPOSE: Home  
(home, irrigation, municipal, industrial)

- WELL COMPLETION DATA:
- (1) diameter (inches) 2"
  - (2) total depth (feet) 168
  - (3) static water level (feet) 85 below top of ground.
  - (4) casing Plastic 162' (material), (depth),  
2" (size) if telescope see back.
  - (5) screen 6' 162' (length), (depth to top)  
2 (size), plastic gravel (material)
  - (6) pump 3/3 (HP), (yield gpm)  
Electric (type power)
  - (7) electric log no (yes or no)
  - (organization running log)
  - (8) how well bottom plugged Buckshot

**CODED**


MAR 10 1970

MISS. BD. OF  
WATER COMM.

DRILLERS REMARKS:

If well telescopes please sketch and show depths.

GROUND LEVEL

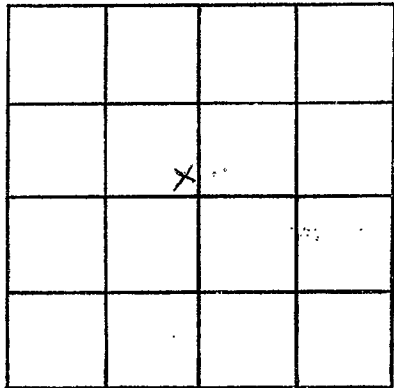

SECTION 29

Please indicate well location X.

ADDITIONAL INFORMATION

If more than one screen,  
show locations of each on sketch.