

Marshall
 J 28
 3-14-70

MISSISSIPPI
 BOARD OF WATER COMMISSIONERS
 416 North State Street
 Jackson, Mississippi 39201



WATER WELL DRILLERS LOG

March 14 1970 data well completed
 Earl Jones Well Co. firm name
 Marshall county well located

LANDOWNER: S. W. Jones
 Byhalis Miss.
 RT 3
 (mailing address)

description of formations encountered	depth	
	from	to
Trassil & clay	0	18
sand	18	25
clay	25	27
sand	27	168

WELL LOCATION:
 sec. 16 T 3 N R 4 E
 1 1/4 miles S.W. of Victoria
 (distance) (direction) (nearest town)

WELL PURPOSE: Home
 (home, irrigation, municipal, industrial)

WELL COMPLETION DATA:

- (1) diameter (inches) 2
- (2) total depth (feet) 168
- (3) static water level (feet) 98 below top of ground.
- (4) casing Plastic 162 ft (material) (depth)
 (size) if telescope see back.
- (5) screen 6 ft 162 ft (length) (depth to top)
 2" (size) plastic - gravel (material)
- (6) pump 1 3 (HP) (yield gpm)
 Electric (type power)
- (7) electric log no (yes or no)
- (organization running log)
- (8) how well bottom plugged Burchett




APR 13 1970

MISS. BD. OF
 WATER COMM.

DRILLERS REMARKS:

If well telescopes please sketch and show depths.

GROUND LEVEL

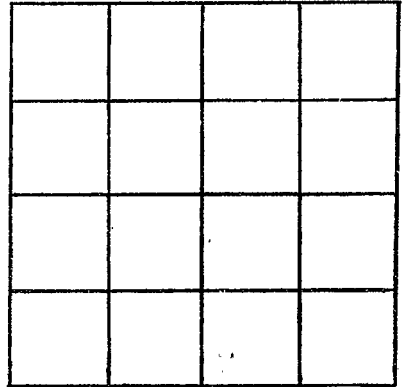

SECTION _____

Please indicate well location X.

ADDITIONAL INFORMATION

If more than one screen, show locations of each on sketch.