

Marshall
J 30
5-21-70
3

MISSISSIPPI
BOARD OF WATER COMMISSIONERS
416 North State Street
Jackson, Mississippi 39201

CODED
CODED

DC WATER WELL DRILLERS LOG

May 21 1970 Earl Jones Well Co. Marshall
date well completed firm name county well located

LANDOWNER:
Joe Harris
Red Banks, Miss. Rt 1
(mailing address)

WELL LOCATION:
sec. 3 T 3 N R 4 E
3/4 miles East of Vicksburg
(distance) (direction) (nearest town)

WELL PURPOSE: Home
(home, irrigation, municipal, industrial)

- WELL COMPLETION DATA:
- (1) diameter (inches) 2
 - (2) total depth (feet) 166
 - (3) static water level (feet) 100 below top of ground.
 - (4) casing plastic 160 (material) (depth)
 - (size) If telescope see back.
 - (5) screen 6' 160 (length) (depth to top)
 - 2" plastic gravel (size) (material)
 - (6) pump 1 4 (HP) (yield gpm)
 - Electric (type power)
 - (7) electric log no (yes or no)
 - (organization running log)
 - (8) how well bottom plugged bucketshot

description of formations encountered	depth	
	from	to
Topsoil & clay	0	17
sand	17	40
clay	40	50
sand	50	90
clay	90	100
sand	100	140
clay	140	145
sand	145	166

CODED


JUN 8 1970

MISS. BD. OF
WATER COMM.

DRILLERS REMARKS:

If well telescopes please sketch and show depths.

GROUND LEVEL

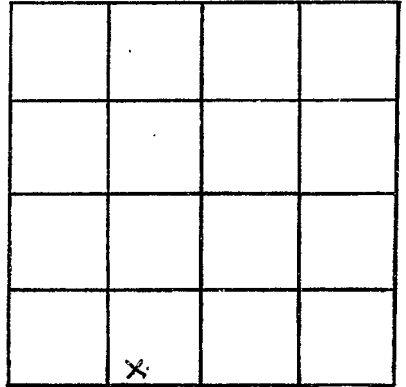

SECTION 3

Please indicate well location X.

ADDITIONAL INFORMATION

If more than one screen, show locations of each on sketch.