

Marshall  
J 31

MISSISSIPPI  
BOARD OF WATER COMMISSIONERS  
416 North State Street  
Jackson, Mississippi 39201

**CODED**  
**CODED**

WATER WELL DRILLERS LOG

19 Attetson & Frost Marshall  
date well completed firm name county well located

LANDOWNER:  
Ernest Webb  
Byhalia Miss  
(mailing address)

description of formations encountered	from	to
<u>Clay</u>	<u>0</u>	<u>10</u>
<u>sand</u>	<u>10</u>	<u>98</u>
<u>sand</u>	<u>58</u>	<u>91</u>
<u>white sand</u>	<u>91</u>	<u>126</u>

WELL LOCATION:  
sec. 8 T. 3 N. R. 4 E. 217  
2 miles SE of Wesson  
(distance) (direction) (nearest town)

WELL PURPOSE: None  
(home, irrigation, municipal, industrial)

- WELL COMPLETION DATA:
- (1) diameter (inches) 4"
  - (2) total depth (feet) 126
  - (3) static water level (feet) 80 below top of ground.
  - (4) casing P.O.C., 116,  
(material) (depth)  
(size) If telescope see back.
  - (5) screen 10, 116  
(length) (depth to top)  
4", P.O.C. & sand  
(size) (material)
  - (6) pump 3/4, 12  
(HP) (yield gpm)  
elec.  
(type power)
  - (7) electric log \_\_\_\_\_  
(yes or no)  
  
(organization running log)
  - (8) how well bottom plugged COP.

**CODED**


MAY 18 1970

MISS. BD. OF  
WATER COMM.

DRILLERS REMARKS:

If well telescopes please sketch and show depths.

GROUND LEVEL

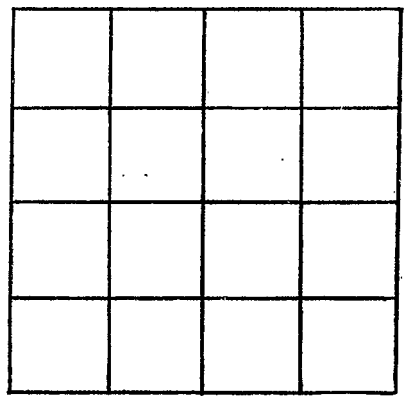

SECTION \_\_\_\_\_

Please indicate well location X.

ADDITIONAL INFORMATION

A series of horizontal lines for writing additional information, starting below the 'ADDITIONAL INFORMATION' header and extending to the bottom of the page.

If more than one screen, show locations of each on sketch.