

MISSISSIPPI
BOARD OF WATER COMMISSIONERS
416 North State Street
Jackson, Mississippi 39201

CODED

WATER WELL DRILLERS LOG

Marshall
J 32
8-24-70

Aug 24 19 70 Earl Jones Well co. Marshall
date well completed firm name county well located

LANDOWNER:
John W. McCawley
Byhalia miss. RT1
(mailing address)

description of formations encountered	depth	
	from	to
<u>Topsoil + clay</u>	<u>0</u>	<u>12</u>
<u>sand</u>	<u>12</u>	<u>20</u>
<u>clay</u>	<u>20</u>	<u>30</u>
<u>sand</u>	<u>30</u>	<u>60</u>
<u>clay</u>	<u>60</u>	<u>64</u>
<u>sand</u>	<u>64</u>	<u>105</u>

WELL LOCATION:
sec. 21 T 3 N R 4 E
3 1/4 miles north to Victoria
(distance) (direction) (nearest town)

WELL PURPOSE: Home
(home, irrigation, municipal, industrial)

WELL COMPLETION DATA:

(1) diameter (inches) 2"

(2) total depth (feet) 105

(3) static water level (feet) 80 below above top of ground.

(4) casing plastic, 99 ft.
(material) (depth)
2" If telescope see back.
(size)

(5) screen 6 ft., 99 ft.
(length) (depth to top)
2 plastic filter pos.
(size) (material)

(6) pump 3/4 6
(HP) (yield gpm)
electric
(type power)

(7) electric log no
(yes or no)

(organization running log)

(8) how well bottom plugged plastic cap

CODED


SEP 23 1970

MISS. BD. OF
WATER COMM.

DRILLERS REMARKS:

If well telescopes please sketch and show depths.

GROUND LEVEL

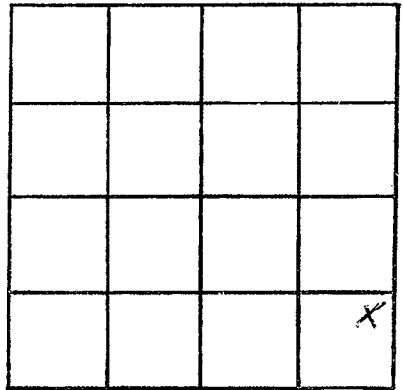

SECTION 21

Please indicate well location X.

ADDITIONAL INFORMATION

If more than one screen,
show locations of each on sketch.