

Marshall
 T 33
 9-19-70

MISSISSIPPI
 BOARD OF WATER COMMISSIONERS
 416 North State Street
 Jackson, Mississippi 39201

CODED

WATER WELL DRILLERS LOG

Sept 19 1970 Earl Jones Well Co. Marshall
 date well completed firm name county well located

LANDOWNER: Woodrow Waldrop
 Red Bank, Miss. RT1
 (mailing address)
 WELL LOCATION:
 sec 10 T 3 N R 4 E
 (S) (W)
 3/4 miles E of Victoria
 (distance) (direction) (nearest town)

description of formations encountered	from	to
	Top soil & clay	0
sand.	18	48
clay	48	60
sand.	60	90
clay + sand.	90	120
sand.	120	146

WELL PURPOSE: Home
 (home, irrigation, municipal, industrial)

WELL COMPLETION DATA:
 (1) diameter (inches) 2"
 (2) total depth (feet) 146
 (3) static water level (feet) 95 below above top of ground.
 (4) casing Plastic 140'
 (material) (depth)
 2" if telescope see back.
 (size)
 (5) screen 6' 140'
 (length) (depth to top)
 2" Plastic-Filter
 (size) (material)
 (6) pump 1' 6'
 (HP) (yield gpm)
 Electric
 (type power)
 (7) electric log no
 (yes or no)
 (organization running log)
 (8) how well bottom plugged
 Plastic Case

CODED


SEP 23 1970

MISS. BD. OF
 WATER COMM.

DRILLERS REMARKS:

If well telescopes please sketch and show depths.

GROUND LEVEL

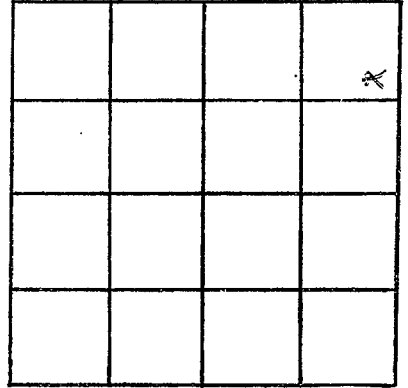

SECTION _____

Please indicate well location X.

ADDITIONAL INFORMATION

If more than one screen,
show locations of each on sketch.