

MARSHALL
J 35
7-28-70

MISSISSIPPI
BOARD OF WATER COMMISSIONERS
416 North State Street
Jackson, Mississippi 39201

CODED

WATER WELL DRILLERS LOG

July 28 1970 Earl Jones Well Co. Marshall
(date well completed) (firm name) (county well located)

LANDOWNER:

Martin Beeman

description of formations encountered

from

to

Dyholio Miss RT 1
(mailing address)

Topsail	0	4
sand	4	18
rock	18	20
sand	20	40
clay + sand mixed	40	120
sand	120	147

WELL LOCATION:

sec 28 T 3 N R 4 E
2 1/2 miles north of Victoria
(distance) (direction) (nearest town)

WELL PURPOSE:

Home
(home, irrigation, municipal, industrial)

WELL COMPLETION DATA:

- (1) diameter (inches) 2"
- (2) total depth (feet) 147
- (3) static water level (feet) 85' below top of ground.
- (4) casing plastic, 141 ft.
(material) (depth)
(size) if telescope see back.
- (5) screen 6 ft, 141 ft.
(length) (depth to top)
2" Filter pack plastic
(size) (material)
- (6) pump 3/4 (HP), 4 1/2 (yield gpm)
Electric (type power)
- (7) electric log no.
(yes or no)

CODED

(organization running log)

- (8) how well bottom plugged
plastic cap.


AUG 11 1970

DRILLERS REMARKS:

MISS. BD. OF
WATER COMM.

If well telescopes please sketch and show depths.

GROUND LEVEL

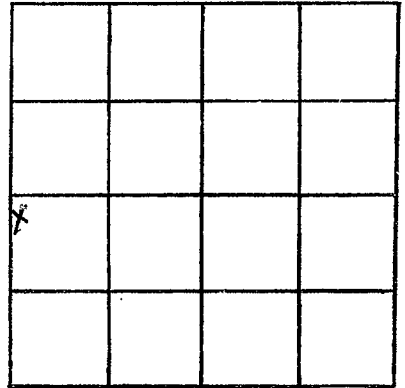

SECTION 28

Please indicate well location X.

ADDITIONAL INFORMATION

If more than one screen, show locations of each on sketch.