

MARSHALL
J 36
8-27-70

MISSISSIPPI
 BOARD OF WATER COMMISSIONERS
 416 North State Street
 Jackson, Mississippi 39201

CODED

WATER WELL DRILLERS LOG

8-27-1970 Bob Smith Marshall
 date well completed firm name county well located

LANDOWNER: Leo Fortune
Victoria, Miss.
 (mailing address)

description of formations encountered	from	to
<u>top soil</u>	<u>0</u>	<u>5</u>
<u>red clay</u>	<u>5</u>	<u>20</u>
<u>white sand</u>	<u>20</u>	<u>160</u>

WELL LOCATION:
 sec. 10 T. 23 N. R. 4 E
1 miles South of Vict.
 (distance) (direction) (nearest town)

WELL PURPOSE: Home
 (home, irrigation, municipal, industrial)

CODED

- WELL COMPLETION DATA:
- (1) diameter (inches) 4
 - (2) total depth (feet) 160
 - (3) static water level (feet) 6 below above top of ground.
 - (4) casing Plastic, 160
 (material) (depth)
 (size) if telescope see back.
 - (5) screen 20, 140
 (length) (depth to top)
4, Plastic
 (size) (material)
 - (6) pump 3/4, 15
 (HP) (yield gpm)
Electric
 (type power)
 - (7) electric log no
 (yes or no)
 (organization running log)
 - (8) how well bottom plugged plugged


DRILLERS REMARKS:

DEC 7 1970

MISS. BD. OF
 WATER COMM.

If well telescopes please sketch and show depths.

GROUND LEVEL

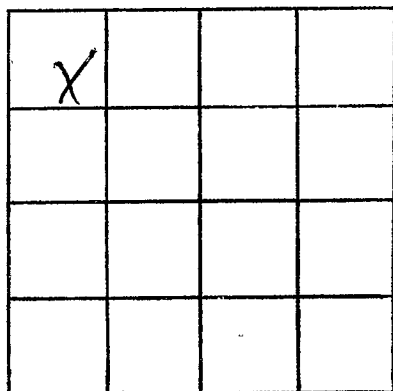

SECTION _____

Please indicate well location X.

ADDITIONAL INFORMATION

If more than one screen,
show locations of each on sketch.