

MARSHALL

J 37

? 3-71

MISSISSIPPI BOARD OF WATER COMMISSIONERS
416 North State Street
Jackson, Mississippi 39201

CODED

WATER WELL DRILLERS LOG

Atkinson & Frost *Marshall*

date well completed

firm name

county well located

LANDOWNER: *Tom Rizer*

Victoria Mine

(mailing address)

WELL LOCATION:

sec. 3 T 3 N R 4 E
3 miles E of WARSAW
(distance) (direction) (nearest town)

WELL PURPOSE:

(home, irrigation, municipal, industrial)

WELL COMPLETION DATA:

- (1) diameter (inches) 4"
- (2) total depth (feet) 145
- (3) static water level (feet) 130 below top of ground.
- (4) casing P.V.C. 145
(material) (depth)
- (size) If telescope see back.
- (5) screen 10 135
(length) (depth to top)
- 4" P.V.C.
(size) (material)
- (6) pump 3/4 10
(HP) (yield gpm)
- Elec.
(type power)
- (7) electric log
(yes or no)
- (organization running log)
- (8) how well bottom plugged cap.

description of formations encountered

from

to

<i>Red clay</i>	<i>0</i>	<i>15</i>
<i>11 shale</i>	<i>15</i>	<i>55</i>
<i>White clay sand</i>	<i>55</i>	<i>100</i>
<i>White clay</i>	<i>100</i>	<i>105</i>
<i>White shale</i>	<i>105</i>	<i>145</i>

CODED


APR 5 1971

MISS. BD. OF WATER COMMISSIONERS

DRILLERS REMARKS:

If well telescopes please sketch and show depths.

GROUND LEVEL

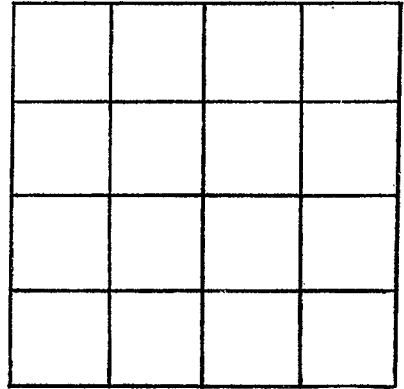

SECTION _____

Please indicate well location X.

ADDITIONAL INFORMATION

If more than one screen, show locations of each on sketch.