

MARSHALL
J 38
3-28-71

MISSISSIPPI
 BOARD OF WATER COMMISSIONERS
 416 North State Street
 Jackson, Mississippi 39201

CODED

WATER WELL DRILLERS LOG

March 28 1971 date well completed
 Earl Jones Well Co firm name
 Marshall county well located

LANDOWNER:
 W.C. Ellis
 4938 Marianne Lane
 Memphis Tenn
 (mailing address)

description of formations encountered	depth	
	from	to
Topsoil	0	10
sand	10	40
clay	40	70
sand	70	120

WELL LOCATION:
 sec 16 T 3 N R 4 E
 2 miles S of Victoria
 (distance) (direction) (nearest town)

WELL PURPOSE: Farm
 (home, irrigation, municipal, industrial)

- WELL COMPLETION DATA:
- (1) diameter (inches) 4"
 - (2) total depth (feet) 120
 - (3) static water level (feet) 70 below top of ground.
 - (4) casing plastic (material), 115 (depth), 4" (size) if telescope see back.
 - (5) screen 5' (length), 115' (depth to top), 4" (size), plastic gravel (material)
 - (6) pump 3/4 (HP), 12 (yield gpm), Electric (type power)
 - (7) electric log no (yes or no)
 - (organization running log)
 - (8) how well bottom plugged plastic cap

CODED


APR 19 1971

MISS. ED. OF WATER COM.

DRILLERS REMARKS:

If well telescopes please sketch and show depths.

GROUND LEVEL

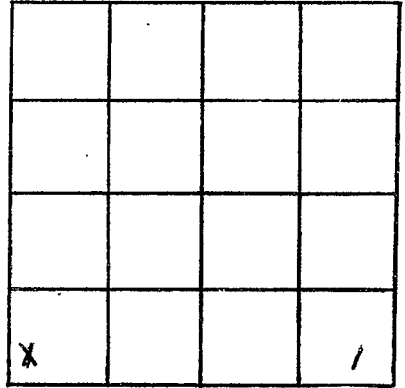

SECTION _____

Please indicate well location X.

ADDITIONAL INFORMATION

If more than one screen, show locations of each on sketch.