

**MARSHALL**  
**J-41**  
**8-13-71**

MISSISSIPPI  
 BOARD OF WATER COMMISSIONERS  
 416 North State Street  
 Jackson, Mississippi 39201

**CODED**

WATER WELL DRILLERS LOG

Aug 13 1971 Ene Jones Well Co Marshall  
 date well completed firm name county well located


LANDOWNER:	description of formations encountered	from	to
<u>Payton Lee</u>	<u>Clay to Topsoil</u> <u>sand</u> <u>rocks</u> <u>sand</u> <u>clay</u> <u>sand</u>	0	20
<u>Red Banks Miss Rt 1</u>		20	30
(mailing address)		30	32
WELL LOCATION:		32	50
sec. <u>10</u> T <u>3</u> N R <u>4</u> E S W		50	55
<u>1/2</u> miles <u>East</u> of <u>Victoria</u> (distance) (direction) (nearest town)	55	145	
WELL PURPOSE: <u>Home</u> (home, irrigation, municipal, industrial)			
WELL COMPLETION DATA:			
(1) diameter (inches) <u>2"</u>			
(2) total depth (feet) <u>145'</u>			
(3) static water level (feet) <u>95'</u> below top of ground.			
(4) casing <u>plastic</u> <u>139'</u> (material) (depth)			
<u>2"</u> (size) if telescope see back.			
(5) screen <u>6'</u> <u>139'</u> (length) (depth to top)			
<u>2"</u> <u>plastic filter fabric</u> (size) (material)			
(6) pump <u>3/4</u> <u>4 1/2</u> (HP) (yield gpm)			
<u>Electric</u> (type power)			
(7) electric log <u>no</u> (yes or no)			
(organization running log)			
(8) how well bottom plugged <u>plastic cap</u>			
DRILLERS REMARKS:			

AUG 31 1971

MISS. BD. OF  
 WATER COMM.

If well telescopes please sketch and show depths.

GROUND LEVEL

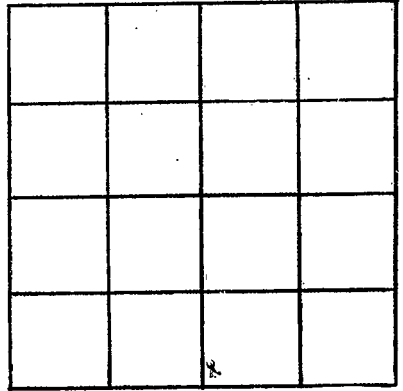

SECTION 10

Please indicate well location X.

ADDITIONAL INFORMATION

If more than one screen, show locations of each on sketch.