

**MARSHALL**  
**J-42**  
**8-5-71**

MISSISSIPPI  
 BOARD OF WATER COMMISSIONERS  
 416 North State Street  
 Jackson, Mississippi 39201

WATER WELL DRILLERS LOG

**CODED**

Aug 5 19 71 Earl Jones Well Co. Marshall  
 date well completed firm name county well located

LANDOWNER:

A. L. Waldrop

Red Bank, Miss. RT 1  
 (mailing address)

WELL LOCATION:

sec. 10 T. 3 N. R. 4 E  
2/3 miles East of Victoria  
 (distance) (direction) (nearest town)

WELL PURPOSE: Home  
 (home, irrigation, municipal, industrial)

WELL COMPLETION DATA:

- (1) diameter (inches) 2"
- (2) total depth (feet) 155'
- (3) static water level (feet) 100 below above top of ground.
- (4) casing plastic 150'  
 (material) (depth)  
2" If telescope see back.  
 (size)
- (5) screen 6' 150'  
 (length) (depth to top)  
2 plastic - Filter por.  
 (size) (material)
- (6) pump 1 5  
 (HP) (yield gpm)  
Electric  
 (type power)
- (7) electric log no  
 (yes or no)

(organization running log)

(8) how well bottom plugged  
plastic cap

description of formations encountered

from

to

<del>0-18</del> Topsoil + clay	0	18
sand	18	35
clay	35	38
sand	38	60
rock	60	61
sand	61	90
clay	90	94
sand	94	155


DRILLERS REMARKS:

AUG 31 1971

MISS. BD. OF  
 WATER COMM.

If well telescopes please sketch and show depths.

GROUND LEVEL

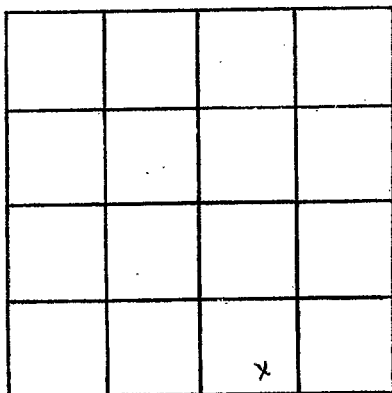

SECTION 10

Please indicate well location X.

ADDITIONAL INFORMATION

If more than one screen,  
show locations of each on sketch.