

**MISSISSIPPI  
BOARD OF WATER COMMISSIONERS**  
416 North State Street  
Jackson, Mississippi 39201

**WATER WELL DRILLERS LOG**

**CODED**

**Marshall**  
**J-44**  
**5-71**

date well completed 19 Atkinson & Faust firm name Mississippi county well located

**LANDOWNER:** Robert Wilson  
Bygdalia, Miss  
  
(mailing address)

| description of formations encountered | from                       | to                    |
|---------------------------------------|----------------------------|-----------------------|
|                                       | <u>Clay</u><br><u>sand</u> | <u>0</u><br><u>10</u> |

**WELL LOCATION:**  
sec. 3 T. 3 N. R. 4 E.  
1/2 miles SE of Bygdalia  
(distance) (direction) (nearest town)

**WELL PURPOSE:** None  
(home, irrigation, municipal, industrial)

- WELL COMPLETION DATA:**
- (1) diameter (inches) 4"
  - (2) total depth (feet) 120
  - (3) static water level (feet) 90 below above top of ground.
  - (4) casing P.V.C. 120  
(material) (depth)  
(size) if telescope see back.
  - (5) screen 10 110  
(length) (depth to top)  
4" P.V.C.  
(size) (material)
  - (6) pump 3/4 12  
(HP) (yield gpm)  
Elec.  
(type power)
  - (7) electric log yes or no  
  
(organization running log)
  - (8) how well bottom plugged CAP

**CODED**


**SEP 15 1971**

**DRILLERS REMARKS:**

MISS. BD. OF  
WATER COMMISSIONERS

If well telescopes please sketch and show depths.

GROUND LEVEL

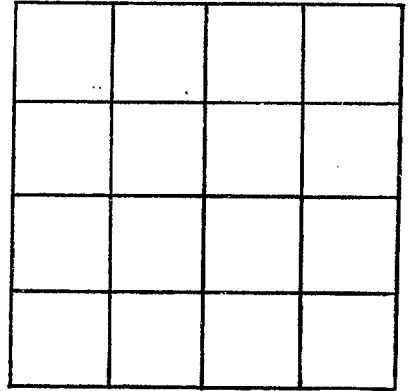

SECTION \_\_\_\_\_

Please indicate well location X.

ADDITIONAL INFORMATION

If more than one screen, show locations of each on sketch.