

Marshall  
 J 47  
 6-66

MISSISSIPPI  
 BOARD OF WATER COMMISSIONERS  
 416 North State Street  
 Jackson, Mississippi 39201

**CODED**

WATER WELL DRILLERS LOG

6 1966 Robert M. Wilson Marshall  
 date well completed firm name county well located

LANDOWNER: W. M. Jones  
Holly Springs  
Miss.  
 (mailing address)

description of formations encountered	from	to
Red dirt	0	10
Red Sand	10	50
Red Sand & clay	50	60
White Sand & clay	60	70
White Sand	70	170


WELL LOCATION:  
 sec. 11 T. 3 N R. 4 E  
 (S) (W)  
4 miles W of Red Banks  
 (distance) (direction) (nearest town)

WELL PURPOSE: home  
 (home, irrigation, municipal, industrial)

WELL COMPLETION DATA:

- (1) diameter (inches) 4"
- (2) total depth (feet) 170'
- (3) static water level (feet) 140 <sup>(below)</sup> <sub>above</sub> top of ground.
- (4) casing Plastic, 166'  
 (material) (depth)  
4" if telescope see back.  
 (size)
- (5) screen 4', 166'  
20gaw (length) (depth to top)  
4", Gal. Pac. Slotted Pipe  
 (size) (material)
- (6) pump 3/4  
 (HP) (yield gpm)  
Elect.  
 (type power)
- (7) electric log NO  
 (yes or no)  
 (organization running log)
- (8) how well bottom plugged 4"  
Plastic Cap


**CODED**

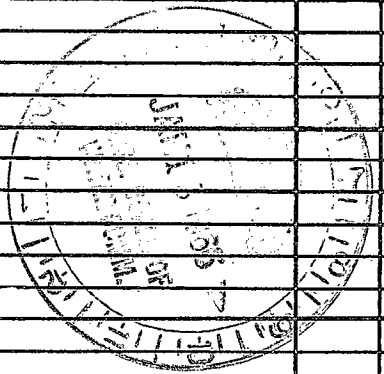

DRILLERS REMARKS:

If well telescopes please sketch and show depths.

GROUND LEVEL

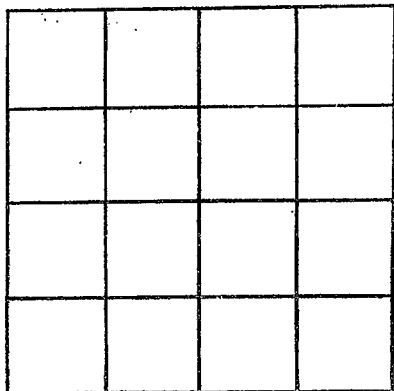

SECTION \_\_\_\_\_

Please indicate well location X.

ADDITIONAL INFORMATION

If more than one screen,  
show locations of each on sketch.