

Marshall
 J50
 3-25-68

MISSISSIPPI
 BOARD OF WATER COMMISSIONERS
 416 North State Street
 Jackson, Mississippi 39201

CODED

WATER WELL DRILLERS LOG

March 25 1968 R. L. Carpenter Marshall
 date well completed firm name county well located

LANDOWNER: James Mathews
 Victoria, Miss.
 (mailing address)

description of formations encountered	from	to
Surface Soil	0	8
Med. Red sand	8	31
Med. white sand	31	47
White Clay	47	70
Med. white sand	70	132
White Clay	132	140
Med. white sand	140	165


WELL LOCATION:
 sec. 16 T. 3 N R. 4 E
 S W
 2 miles South of Victoria
 (distance) (direction) (nearest town)

WELL PURPOSE: Home
 (home, irrigation, municipal, industrial)

WELL COMPLETION DATA:

(1) diameter (inches) 4 in.
 (2) total depth (feet) 165
 (3) static water level (feet) 100 below top of ground.
 (4) casing Plastic, 159, (material) (depth)
 (size) If telescope see back.
 (5) screen 6 Ft., 159 Ft. (length) (depth to top)
 4 in., Plastic & Travel (size) (material)
 (6) pump 3/4 12 (HP) (yield gpm)
 Elec. (type power)
 (7) electric log no (yes or no)
 (organization running log)

CODED

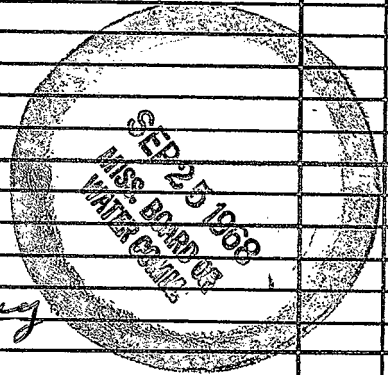

(8) how well bottom plugged Plastic Plug


DRILLERS REMARKS:

If well telescopes please sketch and show depths.

GROUND LEVEL

R4W

T35

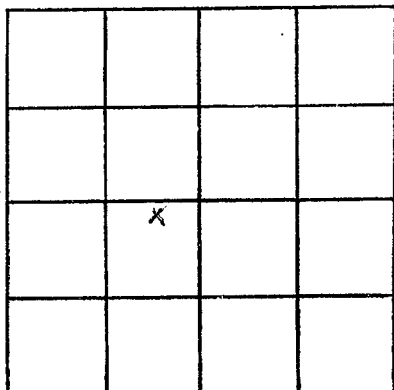

SECTION 16

Please indicate well location X.

ADDITIONAL INFORMATION

If more than one screen, show locations of each on sketch.