

MAYSHALL
 J51
 5-68

MISSISSIPPI
 BOARD OF WATER COMMISSIONERS
 416 North State Street
 Jackson, Mississippi 39201

CODED

WATER WELL DRILLERS LOG

5-30 1968 Lead Well Co Marshall
 date well completed firm name county well located

LANDOWNER: R. A. Hatcher
 Route 2 - Box 159
 description of formations encountered from to
 Bysheba, Miss. Lot # 2 (mailing address)
 Surface clay 0 17
 White fine sand + clay 17 58
 Fine white sand 58 93
 Coarse white sand 93 132

WELL LOCATION:
 sec 10 T 3 N R 4 E
 4 miles East of Bysheba
 (distance) (direction) (nearest town)

WELL PURPOSE: home
 (home, irrigation, municipal, industrial)

WELL COMPLETION DATA:

(1) diameter (inches) 4"
 (2) total depth (feet) 132
 (3) static water level (feet) 61 below top of ground.
 (4) casing Plastic 126 (material), (depth)
 (size) If telescope see back.
 (5) screen 6' 126 (length), (depth to top)
 4 Plastic (size), (material)
 (6) pump 1/2 15 (HP), (yield gpm)
 220 V. (type power)
 (7) electric log No (yes or no)
 (organization running log)
 (8) how well bottom plugged 4" Plastic Cap


CODED

MAY 5 1968
 MISSISSIPPI BOARD OF WATER COMMISSIONERS
 JACKSON, MISSISSIPPI

DRILLERS REMARKS: Well
 capable of producing
 50 g.p.m.

If well telescopes please sketch and show depths.

GROUND LEVEL

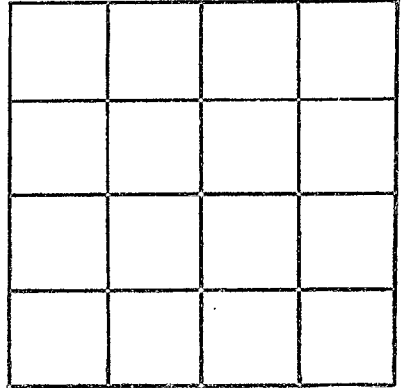

SECTION _____

Please indicate well location X.

ADDITIONAL INFORMATION

If more than one screen, show locations of each on sketch.