

MISSISSIPPI  
 BOARD OF WATER COMMISSIONERS  
 416 North State Street  
 Jackson, Mississippi 39201

**CODED**

WATER WELL DRILLERS LOG

MARSHALL  
 @ J52  
 5-68

5-23 1968 Leake Well Co Marshall  
 date well completed firm name county well located

LANDOWNER: Jack Panner  
Byhalia Miss  
 (mailing address)

description of formations encountered	from	to
Surface clay	0	31
White Sand + clay	31	70
White Sand fine	70	100
Coarse White Sand	100	136

WELL LOCATION:  
 sec. 10 T. 3 N R. 4 E  
4 miles E of Byhalia  
 (distance) (direction) (nearest town)

WELL PURPOSE: home  
 (home, irrigation, municipal, industrial)

- WELL COMPLETION DATA:
- (1) diameter (inches) 4
  - (2) total depth (feet) 136
  - (3) static water level (feet) 64 below above top of ground.
  - (4) casing Plastic, 130,  
 (material) (depth)  
 \_\_\_\_\_ If telescope see back.  
 (size)
  - (5) screen 6', 130  
 (length) (depth to top)  
4", Plastic  
 (size) (material)
  - (6) pump \_\_\_\_\_  
 (HP) (yield gpm)  
 \_\_\_\_\_  
 (type power)
  - (7) electric log \_\_\_\_\_  
 (yes or no)  
 \_\_\_\_\_  
 (organization running log)
  - (8) how well bottom plugged \_\_\_\_\_


**CODED**

DRILLERS REMARKS:  
Owner furnished own pump  
+ supply materials

PLANNED TOGETHER  
 MISS. BOARD OF  
 WATER COMMISSIONERS

If well telescopes please sketch and show depths.

GROUND LEVEL

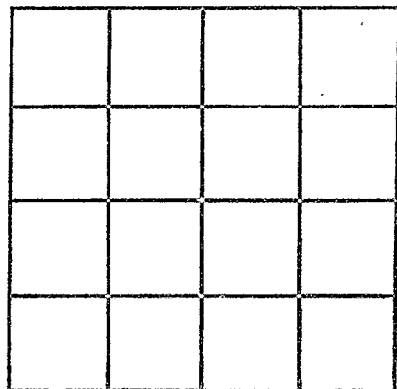

SECTION \_\_\_\_\_

Please indicate well location X.

ADDITIONAL INFORMATION

If more than one screen,  
show locations of each on sketch.