

Atkinson & Frost

MISSISSIPPI  
BOARD OF WATER COMMISSIONERS  
416 North State Street  
Jackson, Mississippi 39201

**CODED**

WATER WELL DRILLERS LOG

Marshall  
#J53  
8-10-68

8-10 1968 Ben Castleberry Marshall  
date well completed firm name county well located

LANDOWNER:  
Ben Castleberry  
(mailing address)

description of formations encountered	from to	
	feet	feet
red clay	0	15
white sand	15	25
white sand	25	90
white clay	90	120
white sand	120	140


WELL LOCATION:  
sec. 1 T. 3 N. R. 4 E.  
6 miles AW of Red Bank  
(distance) (direction) (nearest town)

WELL PURPOSE:  
(home, irrigation, municipal, industrial)

WELL COMPLETION DATA:

- (1) diameter (inches) 4"
- (2) total depth (feet) 140
- (3) static water level (feet) 75 below top of ground
- (4) casing (material) (depth) (size) if telescope see back.
- (5) screen 10 130 (length) (depth to top) (size) (material)
- (6) pump 3 12 (HP) (yield gpm) 230 (type power)
- (7) electric log No (yes or no) (organization running log)
- (8) how well bottom plugged Cap


**CODED**

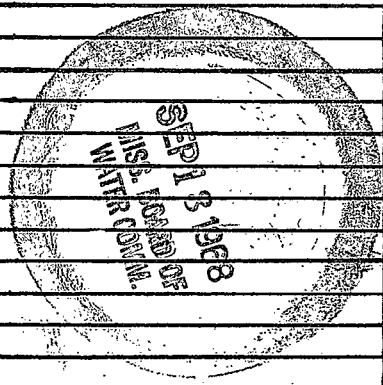

DRILLERS REMARKS:  
See Log

If well telescopes please sketch and show depths.

GROUND LEVEL

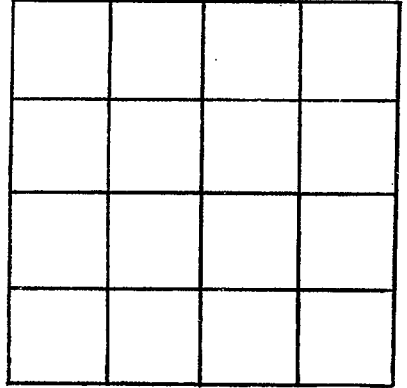

SECTION \_\_\_\_\_

Please indicate well location X.

ADDITIONAL INFORMATION

If more than one screen, show locations of each on sketch.