

MARSHALL
J 55
10-29-71

MISSISSIPPI
 BOARD OF WATER COMMISSIONERS
 416 North State Street
 Jackson, Mississippi 39201

NOV 18 1971

WATER WELL DRILLERS LOG

CODED


Oct 29-71 19 71 Earl Jones Wells Marshall
 date well completed firm name county well located

LANDOWNER:	description of formations encountered	from	to
<u>William Wilson</u>			
<u>Byhalia Miss Rt.</u> (mailing address)	<u>Topsoil</u>	<u>0</u>	<u>12</u>
	<u>sand</u>	<u>12</u>	<u>35</u>
	<u>clay</u>	<u>35</u>	<u>50</u>
	<u>sand</u>	<u>50</u>	<u>124</u>
WELL LOCATION:			
sec. <u>5</u> T. <u>3</u> N. R. <u>4</u> E.			
<u>1 1/2</u> miles <u>West</u> of <u>Victoria</u> (distance) (direction) (nearest town)			
WELL PURPOSE: <u>Home</u> (home, irrigation, municipal, industrial)			
WELL COMPLETION DATA:			
(1) diameter (inches) <u>2"</u>			
(2) total depth (feet) <u>124 ft</u>			
(3) static water level (feet) <u>80</u> below top of ground.			
(4) casing <u>plastic</u> , <u>118'</u> (material) (depth) <u>2"</u> (size) if telescope see back.			
(5) screen <u>6 ft</u> , <u>118'</u> (length) (depth to top) <u>2"</u> , <u>plastic filter paper</u> (size) (material)			
(6) pump <u>1</u> , <u>4</u> (HP) (yield gpm) <u>Electric</u> (type power)			
(7) electric log <u>no</u> (yes or no)			
(organization running log)			
(8) how well bottom plugged <u>plastic cap</u>			
DRILLERS REMARKS:			

CODED

If well telescopes please sketch and show depths.

GROUND LEVEL

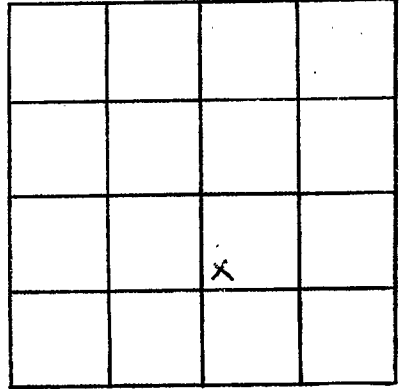

SECTION 5

Please indicate well location X.

ADDITIONAL INFORMATION

If more than one screen,
show locations of each on sketch.