

MARSHALL
J 56
11-15-71

MISSISSIPPI
 BOARD OF WATER COMMISSIONERS **DEC 17 1971**
 416 North State Street
 Jackson, Mississippi 39201

CODED

WATER WELL DRILLERS LOG

11-15 1971 Dean Kent Burrows Well MARSHALL
 date well completed firm name county well located

LANDOWNER:

Jerry Clayton
Halls Springs, Miss.
 (mailing address)

description of formations encountered

from to

Clay	0	40
Sand	40	70
Clay	70	80
Sand	80	180

WELL LOCATION:

sec. 11 T. 3 N. R. 4 E.
8 miles West of Halls Springs
 (distance) (direction) (nearest town)

WELL PURPOSE:

Private
 (home, irrigation, municipal, industrial)

WELL COMPLETION DATA:

- (1) diameter (inches) 4"
- (2) total depth (feet) 180 feet
- (3) static water level (feet) 100 feet below top of ground.
- (4) casing pvc, 180 feet
 (material) (depth)
 (size) if telescope see back.
- (5) screen 6 feet, 174 feet
 (length) (depth to top)
4", gravel wall
 (size) (material)
- (6) pump 3/4, 10
 (HP) (yield gpm)
 (type power)
- (7) electric log elect.
 (yes or no)
 (organization running log)
- (8) how well bottom plugged 4" cof.

CODED


DRILLERS REMARKS:

Sand well
80 feet water

If well telescopes please sketch and show depths.

203

GROUND LEVEL

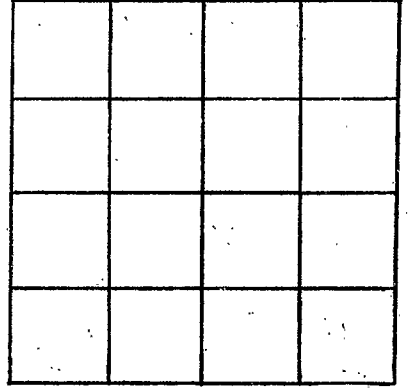

SECTION _____

Please indicate well location X.

ADDITIONAL INFORMATION

A series of horizontal lines for recording additional information, including well location X. There are approximately 20 lines in total, providing space for detailed notes.

If more than one screen,
show locations of each on sketch.