

CODED

MARSHALL
J57
6-16-71

MISSISSIPPI
BOARD OF WATER COMMISSIONERS
416 North State Street
Jackson, Mississippi 39201

FEB 22 1972

WATER WELL DRILLERS LOG

MISS. NO. OR


June 16 1971 R. L. Carpenter Marshall
date well completed firm name county well located

LANDOWNER:	description of formations encountered	from	to
Hardy Huddle Holly Springs, Miss.	Surface Soil	0	18
(mailing address)	Med Red Sand	18	50
WELL LOCATION: sec. 10 T. 3 N R. 4 E	Fine white sand	50	123
1 miles East of Victoria	White Clay	123	140
(distance) (direction) of (nearest town)	Fine white sand	140	210
WELL PURPOSE: Subirrigation	White Clay	210	235
(home, irrigation, municipal, industrial)	White coarse sand	235	290
WELL COMPLETION DATA:			
(1) diameter (inches) 11			
(2) total depth (feet) 290			
(3) static water level (feet) 132 below top of ground.			
(4) casing Plastic, 266 ft. (material) (depth)			
(size) If telescope see back.			
(5) screen 24 ft., 266 ft. (length) (depth to top)			
4 in., Plastic & Gravel (size) (material)			
(6) pump 5 (HP) 70 (yield gpm)			
Elec. (type power)			
(7) electric log no (yes or no)			
(organization running log)			
(8) how well bottom plugged Plastic cap			
DRILLERS REMARKS:			

CODED

If well telescopes please sketch and show depths.

GROUND LEVEL

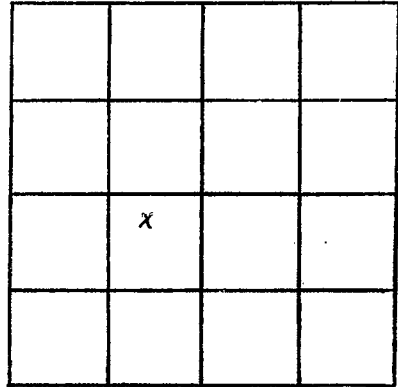

SECTION 10

Please indicate well location X.

ADDITIONAL INFORMATION

If more than one screen, show locations of each on sketch.