

MARSHALL

J 59

2-11-72

MISSISSIPPI
BOARD OF WATER COMMISSIONERS
416 North State Street
Jackson, Mississippi 39201

CODED

WATER WELL DRILLERS LOG

Feb 11

19

72 Earl Jones Wells

Marshall

date well completed

firm name

county well located

LANDOWNER:

P. Douglas Phipps

Holly Springs Miss. RT 4
(mailing address)

WELL LOCATION:

sec **36** T **3** N

R **4** E

3 1/2

miles

(distance)

(direction)

of **Red Bank**

(nearest town)

WELL PURPOSE:

Home
(home, irrigation, municipal, industrial)

WELL COMPLETION DATA:

- (1) diameter (inches) **4"**
- (2) total depth (feet) **150**
- (3) static water level (feet) **85** below top of ground.
- (4) casing **plastic** **144'**
(material) (depth)
4" if telescope see back.
(size)
- (5) screen **6'** **144'**
(length) (depth to top)
4" **plastic - gravel**
(size) (material)
- (6) pump **3/4** **20**
(HP) (yield gpm)
Electric
(type power)
- (7) electric log **no**
(yes or no)

(organization running log)

- (8) how well bottom plugged

plastic cap

DRILLERS REMARKS:

description of formations encountered

from


| | | |
|------|----|-----|
| clay | 0 | 15 |
| sand | 15 | 60 |
| clay | 60 | 64 |
| sand | 64 | 90 |
| clay | 90 | 94 |
| sand | 94 | 150 |

CODED

FEB 28 1972

If well telescopes please sketch and show depths.

GROUND LEVEL

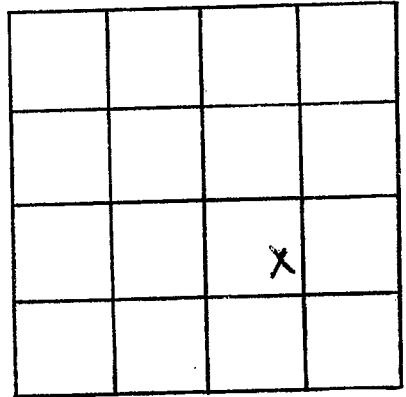

SECTION _____

Please indicate well location X.

ADDITIONAL INFORMATION

If more than one screen,
show locations of each on sketch.