

MARSHALL
J60
3-6-72

MISSISSIPPI
 BOARD OF WATER COMMISSIONERS
 416 North State Street
 Jackson, Mississippi 39201

CODED

WAR 9 1972

WATER WELL DRILLERS LOG


March 6 1972 Deont West Bumpass Marshall
 date well completed firm name county well located

LANDOWNER:	description of formations encountered	from	to
<u>Thelma Perry</u>			
<u>Rt 3, B. Thalia Miss</u> (mailing address)	<u>sand</u>	<u>20</u>	<u>90</u>
WELL LOCATION:	<u>clay</u>	<u>90</u>	<u>95</u>
sec <u>35</u> T <u>3</u> N R <u>4</u> E (S) (W)	<u>sand</u>	<u>95</u>	<u>165</u>
<u>1.2</u> miles <u>South</u> of <u>Holly Springs</u> (distance) (direction) (nearest town)			
WELL PURPOSE: <u>Drilling</u> (home, irrigation, municipal, industrial)			
WELL COMPLETION DATA:			
(1) diameter (inches) <u>4"</u>			
(2) total depth (feet) <u>165 feet</u>			
(3) static water level (feet) <u>110</u> below above top of ground.			
(4) casing <u>PVC</u> , <u>165 feet</u> (material) (depth)			
(size) if telescope see back.			
(5) screen <u>6ft</u> , <u>159 feet</u> (length) (depth to top)			
<u>4"</u> <u>gravel wall</u> (size) (material)			
(6) pump <u>3/4</u> <u>14</u> (HP) (yield gpm)			
(type power)			
(7) electric log <u>Elect</u> (yes or no)			
(organization running log)			
(8) how well bottom plugged <u>4" cap</u>			
DRILLERS REMARKS:			
<u>55 feet water</u> <u>good well</u>			

CODED

If well telescopes please sketch and show depths.

GROUND LEVEL

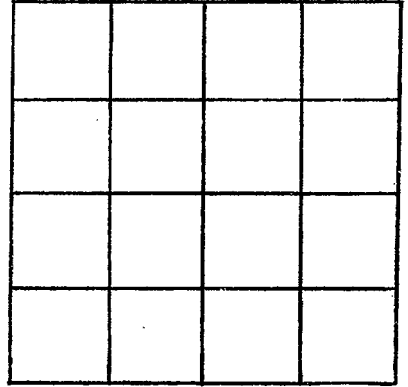

SECTION _____

Please indicate well location X.

ADDITIONAL INFORMATION

If more than one screen,
show locations of each on sketch.