

**MARSHALL**  
**J 61**  
**2-25-72**

**MISSISSIPPI BOARD OF WATER COMMISSIONERS**  
 416 North State Street  
 Jackson, Mississippi 39201

**CODED**

MAR 9 1972

**WATER WELL DRILLERS LOG**

Feb. 25 1972 Dean Kent Bynum, Inc. Marshall  
 date well completed firm name county well located

**LANDOWNER:**

**description of formations encountered**

from to

<u>Quantin Richardson Sr</u>	<u>clay</u>	<u>0</u>	<u>15</u>
<u>Cyprien, Miss</u> (mailing address)	<u>sand</u>	<u>15</u>	<u>60</u>
<b>WELL LOCATION:</b>	<u>clay</u>	<u>60</u>	<u>70</u>
sec. <u>34</u> T. <u>3</u> N R. <u>4</u> E	<u>sand</u>	<u>70</u>	<u>138</u>
<u>10</u> miles <u>west</u> of <u>Bi Si</u>	<u>clay</u>	<u>138</u>	<u>140</u>
(distance) (direction) of (nearest town)	<u>sand</u>	<u>140</u>	<u>150</u>
<b>WELL PURPOSE:</b> <u>Domestic</u> (home, irrigation, municipal, industrial)			

**WELL COMPLETION DATA:**

- (1) diameter (inches) 4"
- (2) total depth (feet) 150 ft
- (3) static water level (feet) 80 ft below top of ground.
- (4) casing PVC 150 ft  
(material) (depth)
- (size) if telescope see back.
- (5) screen 6 ft 14 ft  
(length) (depth to top)
- 4" guard wall  
(size) (material)
- (6) pump 3/4 14  
(HP) (yield gpm)
- (type power)
- (7) electric log elect  
(yes or no)
- (organization running log)
- (8) how well bottom plugged 4" cap


**CODED**

**DRILLERS REMARKS:**

70 feet water  
3rd well

If well telescopes please  
sketch and show depths.

GROUND LEVEL

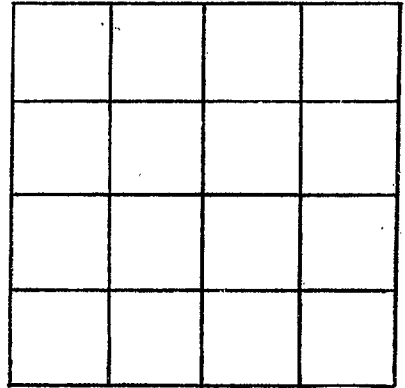

SECTION \_\_\_\_\_

Please indicate well location X.

ADDITIONAL INFORMATION

If more than one screen,  
show locations of each on sketch.