

MARSHALL
J 64
5-16-72

MISSISSIPPI
 BOARD OF WATER COMMISSIONERS
 416 North State Street
 Jackson, Mississippi 39201

CODED

J.A.
lease was not
to Jones mt.
6/72

May 16 1972 Earl Jones Well Co. Marshall
 date well completed firm name county well located

LANDOWNER:
G.E. Ward


Holly Springs, Miss. Rt.
 (mailing address)

WELL LOCATION:
 sec. 26 T 3 N R 4 E
3 1/2 miles SW of Red Bank
 (distance) (direction) (nearest town)

WELL PURPOSE: Home
 (home, irrigation, municipal, industrial)

- WELL COMPLETION DATA:
- (1) diameter (inches) 4"
 - (2) total depth (feet) 165'
 - (3) static water level (feet) 90' below top of ground.
 - (4) casing plastic, 159'
 (material) (depth)
 - 4" if telescope see back.
 (size)
 - (5) screen 6' 159'
 (length) (depth to top)
 - 4", plastic gravel
 (size) (material)
 - (6) pump 1/2 12
 (HP) (yield gpm)
 - Electric
 (type power)
 - (7) electric log no
 (yes or no)
- (organization running log)
- (8) how well bottom plugged plastic cap

description of formations encountered	from	to
TOP Soil + clay	0	18
sand	18	20
clay	20	25
sand	25	165

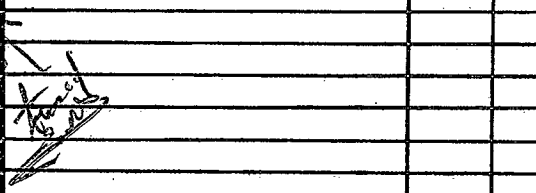

CODED


JUN 5 1972

MISS. Bd. of
 WATER COMMISSIONERS

DRILLERS REMARKS:

If well telescopes please sketch and show depths.

GROUND LEVEL

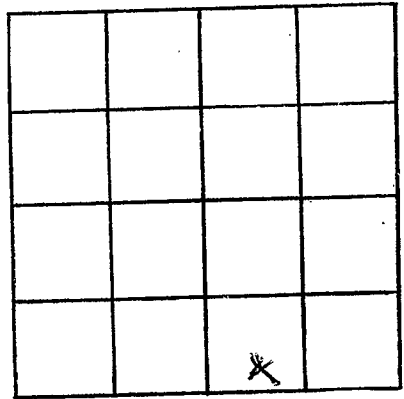

SECTION _____

Please indicate well location X.

ADDITIONAL INFORMATION

If more than one screen,
show locations of each on sketch.