

**MARSHALL**  
**J 66**  
**7-1-72**

MISSISSIPPI  
 BOARD OF WATER COMMISSIONERS  
 416 North State Street  
 Jackson, Mississippi 39201

**CODED**

**WATER WELL DRILLERS LOG**

7/1/72 19 Nicks Brothers Well Co. Marshall  
 date well completed firm name county well located

LANDOWNER: Loretta Sherman  
P.O. Box 361  
Byhalia, Miss.  
 (mailing address)

description of formations encountered	from	to
Red Clay	0	15
Red. sandy clay	15	30
White Sand	30	75
Sandy Clay	75	105
White Sand	105	165

WELL LOCATION:  
 sec. 36 T 3 N. R. 4 E  
8 miles NW of Holly Springs  
 (distance) (direction) (nearest town)

WELL PURPOSE:  
 (home, irrigation, municipal, industrial)

WELL COMPLETION DATA:  
 (1) diameter (inches) 4"  
 (2) total depth (feet) 165  
 (3) static water level (feet) 145 below above top of ground.  
 (4) casing Plastic 140  
 (material) (depth)  
 (size) if telescope see back.  
 (5) screen 5" 5"  
 (length) (depth to top)  
4" Gravel type  
 (size) (material)  
 (6) pump 3/4 10  
 (HP) (yield gpm)  
220 Elec.  
 (type power)  
 (7) electric log \_\_\_\_\_  
 (yes or no)  
 (organization running log)  
 (8) how well bottom plugged cap

**CODED**


JUL 17 1972

REMARKS:

MISS. DD. OF  
 WATER COMM.

If well telescopes please sketch and show depths.

GROUND LEVEL

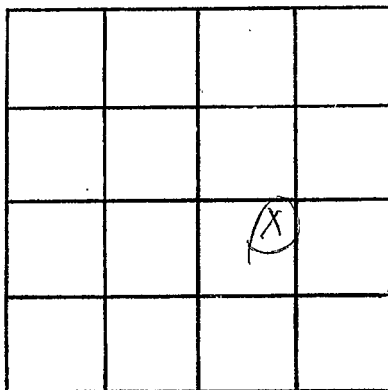

SECTION \_\_\_\_\_

Please indicate well location X.

ADDITIONAL INFORMATION

If more than one screen,  
show locations of each on sketch.