

**CODED**

MISSISSIPPI  
BOARD OF WATER COMMISSIONERS  
416 North State Street  
Jackson, Mississippi 39201

**WATER WELL DRILLERS LOG**

**MARSHALL**  
**J 67**  
**7-8-72**

July 8 1972 Earl Jones Well Co. Marshall  
date well completed firm name county well located

**LANDOWNER:**  
Jacks Shaw  
Victoria Miss.  
(mailing address)

description of formations encountered	from	to
<u>Topsoil &amp; clay</u>	<u>0</u>	<u>15</u>
<u>sand</u>	<u>15</u>	<u>25</u>
<u>clay</u>	<u>25</u>	<u>35</u>
<u>sand.</u>	<u>40</u>	<u>155</u>
<u>clay</u>	<u>155</u>	<u>160</u>
<u>sand</u>	<u>160</u>	<u>198</u>

**WELL LOCATION:**  
sec 9 T 3 N R 4 E  
3/4 miles SW. of Victoria  
(distance) (direction) (nearest town)

**WELL PURPOSE:** Home  
(home, irrigation, municipal, industrial)

- WELL COMPLETION DATA:**
- (1) diameter (inches) 4"
  - (2) total depth (feet) 198
  - (3) static water level (feet) 120 below top of ground.
  - (4) casing plastic 188  
(material) (depth)  
4" if telescope see back.  
(size)
  - (5) screen 10' 188  
(length) (depth to top)  
4" plastic gravel  
(size) (material)
  - (6) pump 1 1/2 25  
(HP) (yield gpm)  
Electric  
(type power)
  - (7) electric log no  
(yes or no)
- (organization running log)
- (8) how well bottom plugged  
plastic cap

**CODED**


MA 13 1972

APPROVED BY  
DATE

**DRILLERS REMARKS:**

If well telescopes please sketch and show depths.

GROUND LEVEL

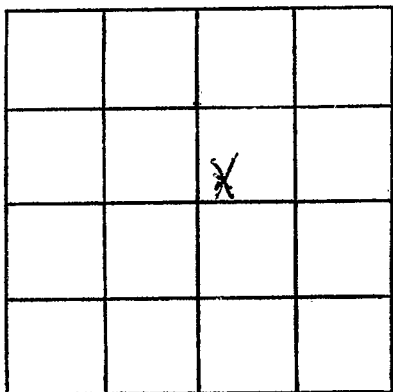

SECTION 9

Please indicate well location X.

ADDITIONAL INFORMATION

If more than one screen,  
show locations of each on sketch.