

MARSHALL
J68
6-16-72

MISSISSIPPI
 BOARD OF WATER COMMISSIONERS
 416 North State Street
 Jackson, Mississippi 39201

WATER WELL DRILLERS LOG

CODED

June 16 1972 date well completed
 Earl Jones Well Co firm name
 Marshall county well located

LANDOWNER: Joe James
Byhalis Miss. Rt.
 (mailing address)

WELL LOCATION:
 sec. 28 T 3 N R 4 E
4 miles S of Victoria
 (distance) (direction) (nearest town)

description of formations encountered	from	to
<u>Topsoil + clay</u>	<u>0</u>	<u>20</u>
<u>sand</u>	<u>20</u>	<u>30</u>
<u>clay + sand mixed</u>	<u>30</u>	<u>60</u>
<u>sand</u>	<u>60</u>	<u>110</u>

WELL PURPOSE: Home
 (home, irrigation, municipal, industrial)

- WELL COMPLETION DATA:
- diameter (inches) 2"
 - total depth (feet) 110
 - static water level (feet) 84 below top of ground.
 - casing plastic, 104
 (material) (depth)
2"
 (size) if telescope see back.
 - screen 6', 104
 (length) (depth to top)
2", plastic gravel
 (size) (material)
 - pump 1, 4
 (HP) (yield gpm)
Electric
 (type power)
 - electric log no
 (yes or no)
- (organization running log)
- (8) how well bottom plugged plastic cap

CODED


JUL 16 1972

DRILLERS REMARKS:

MISS. Bd. OF
 WATER CONTROL

If well telescopes please sketch and show depths.

GROUND LEVEL

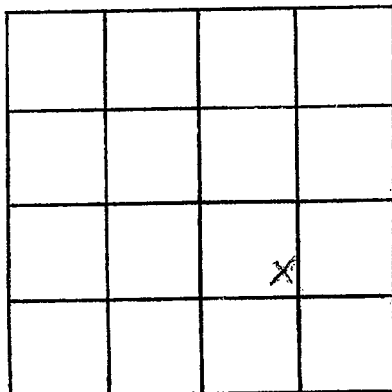

SECTION 28

Please indicate well location X.

ADDITIONAL INFORMATION

If more than one screen,
show locations of each on sketch.