

MARSHALL
J75
10-10-72

MISSISSIPPI
 BOARD OF WATER COMMISSIONERS
 416 North State Street
 Jackson, Mississippi 39201

WATER WELL DRILLERS LOG

Oct 10 1972 Earl Jones Well Co. Marshall
 date well completed from name county well located

CODED

LANDOWNER:
James Chew
Victoria Miss.
 (mailing address)

description of formations encountered	from	to
<u>Topsoil & clay sand</u>	<u>0</u>	<u>14</u>
	<u>14</u>	<u>168</u>

WELL LOCATION:
 sec 9 T 3 N R 4 E
1/8 miles 2 of Victoria
 (distance) (direction) (nearest town)

WELL PURPOSE: Home
 (home, irrigation, municipal, industrial)

WELL COMPLETION DATA:

(1) diameter (inches) 4"

(2) total depth (feet) 108

(3) static water level (feet) 65 below top of ground.

(4) casing plastic, 102'
 (material) (depth)

4" if telescope see back.
 (size)

(5) screen 6", 102'
 (length) (depth to top)

4", plastic gravel
 (size) (material)

(6) pump 1, 12
 (HP) (yield gpm)

Electric
 (type power)

(7) electric log no
 (yes or no)

(organization running log)

CODED

OCT 16 1972


(8) how well bottom plugged
plastic cap

MISSISSIPPI
 WATER COMMISSION

DRILLERS REMARKS:

If well telescopes please sketch and show depths.

GROUND LEVEL

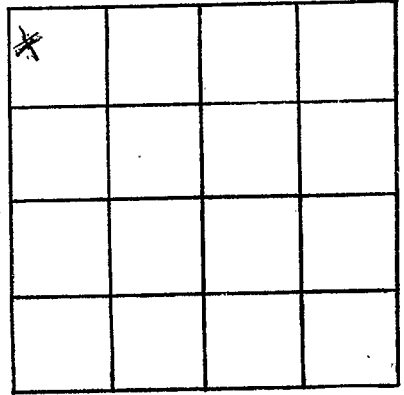

SECTION 7

Please indicate well location X.

ADDITIONAL INFORMATION

A series of horizontal lines for writing additional information.

If more than one screen, show locations of each on sketch.