

MARSHALL

J 76

9-20-72

MISSISSIPPI BOARD OF WATER COMMISSIONERS 416 North State Street Jackson, Mississippi 39201

CODED

WATER WELL DRILLERS LOG

Sept 20

1972

Earl Jones Well Co

Marshall

Date well completed

firm name

county well located

LANDOWNER:

Roger Woods

Holly Springs Miss. (mailing address)

WELL LOCATION:

sec. 16 T3 R4 E2 2 miles SW of Victoria

WELL PURPOSE: Subirrigation (home, irrigation, municipal, industrial)

WELL COMPLETION DATA:

- (1) diameter (inches) 4"
(2) total depth (feet) 210
(3) static water level (feet) 100 below top of ground.
(4) casing 4" (size) if telescope see back.
(5) screen 12" (length) 198 (depth to top) 4" (size) plastic gravel (material)
(6) pump 1 1/2 (HP) 20 (yield gpm) Electric (type power)
(7) electric log no (yes or no)

(organization running log)

(8) how well bottom plugged plastic cap

DRILLERS REMARKS:

description of formations encountered

from

to


Table with 3 columns: description of formations encountered, from, to. Rows include clay, sand, clay & sand mixed, layers of rocks & clay, clay, sand, clay, sand.

CODED

OCT 18 1972

If well telescopes please sketch and show depths.

GROUND LEVEL

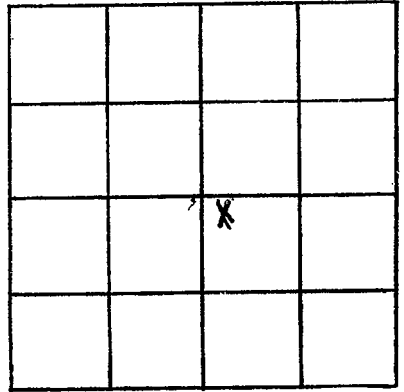

SECTION 16

Please indicate well location X.

ADDITIONAL INFORMATION

If more than one screen, show locations of each on sketch.