

MARSHALL
J 79
11-7-72

MISSISSIPPI
 BOARD OF WATER COMMISSIONERS
 416 North State Street
 Jackson, Mississippi 39201
WATER WELL DRILLERS LOG

Nov 7 1972 Earl Jones Well Co Marshall
 date well completed firm name county well located

LANDOWNER:
Bob Chapman
Victoria Miss.
 (mailing address)

WELL LOCATION:
 sec 3 T. 3 N. R. 4 E.
7/10 miles E of Victoria
 (distance) (direction) (nearest town)

WELL PURPOSE: Home
 (home, irrigation, municipal, industrial)

WELL COMPLETION DATA:

(1) diameter (inches) 4"

(2) total depth (feet) 144

(3) static water level (feet) 75 below top of ground.

(4) casing plastic, 138'
 (material) (depth)
4" if telescope see back.
 (size)

(5) screen 6', 138'
 (length) (depth to top)
4", plastic gravel
 (size) (material)

(6) pump 1/2, 12
 (HP) (yield gpm)
Electric
 (type power)

(7) electric log no.
 (yes or no)

(organization running log)

(8) how well bottom plugged plastic cap


description of formations encountered	from	to
<u>Topsoil + Clay</u>	<u>0</u>	<u>18</u>
<u>sand</u>	<u>18</u>	<u>56</u>
<u>clay</u>	<u>56</u>	<u>64</u>
<u>sand</u>	<u>64</u>	<u>85</u>
<u>layers of clay + sand</u>	<u>85</u>	<u>120</u>
<u>sand</u>	<u>120</u>	<u>144</u>

DRILLERS REMARKS:

DFC 6 19/72

If well telescopes please sketch and show depths.

GROUND LEVEL

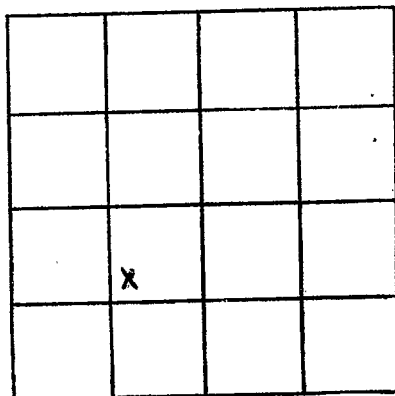

SECTION _____

Please indicate well location X.

ADDITIONAL INFORMATION

If more than one screen,
show locations of each on sketch.