

MARSHALL

J80

12-7-72

MISSISSIPPI
BOARD OF WATER COMMISSIONERS
416 North State Street
Jackson, Mississippi 39201

CODED

WATER WELL DRILLERS LOG

12-7

1972

Dennis H. Bumpas

Marshall

date well completed

firm name

county well located

LANDOWNER:

Calvin Bennett Jr.

Victoria Miss.

(mailing address)

description of formations encountered

Clay

from

to

0

30

Sand

30

120

WELL LOCATION:

sec. 17 T. 3 N. R. 4 E.

3 miles S.W. of Victoria, Miss.

(distance) (direction) (nearest town)

WELL PURPOSE:

(home, irrigation, municipal, industrial)

WELL COMPLETION DATA:

- (1) diameter (inches) 4"
- (2) total depth (feet) 170 feet
- (3) static water level (feet) 110 feet below top of ground.
- (4) casing PVC 170 feet (material) (depth)

(size) If telescope see back.

- (5) screen 7 ft. 163 feet (length) (depth to top)

4" gravel wall (size) (material)

- (6) pump 3/4 14 (HP) (yield gpm)

(type power)

- (7) electric log elect. (yes or no)

(organization running log)

- (8) how well bottom plugged 4" Cog.


DRILLERS REMARKS:

FEB 5 1973

ED. OF
WATER COM.

If well telescopes please
sketch and show depths.

GROUND LEVEL

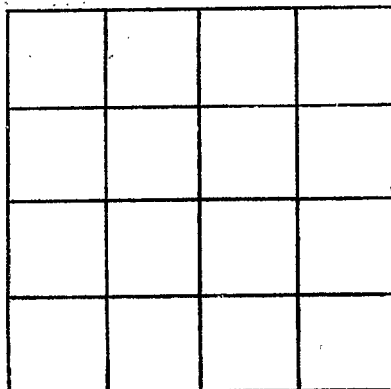

SECTION _____

Please indicate well location X.

ADDITIONAL INFORMATION

If more than one screen,
show locations of each on sketch.