

MARSHALL
J 81
11-11-72

MISSISSIPPI
 BOARD OF WATER COMMISSIONERS
 416 North State Street
 Jackson, Mississippi 39201

CODED

WATER WELL DRILLERS LOG

11-11 1972 Bob Smith Marshall
 date well completed firm name county well located

LANDOWNER:
San Chamber
Red Banks, Miss.
 (mailing address)

description of formations encountered	from	to
<u>clay dirt</u>		<u>8</u>
<u>gravel</u>	<u>8</u>	<u>14</u>

WELL LOCATION:
 sec. 35 T. 3 N. R. 4 E.
4 miles SWS of Red Banks
 (distance) (direction) (nearest town)

<u>red sand</u>	<u>14</u>	<u>47</u>
<u>white sand</u>	<u>47</u>	<u>180</u>

WELL PURPOSE: None
 (home, irrigation, municipal, industrial)

WELL COMPLETION DATA:

(1) diameter (inches) 4

(2) total depth (feet) 180

(3) static water level (feet) 115 below above top of ground.

(4) casing Plastic 180
 (material) (depth)
 (size) if telescope see back.

(5) screen 30 160
 (length) (depth to top)
4 Plastic
 (size) (material)

(6) pump 1/2 10
 (HP) (yield gpm)
Elec
 (type power)

(7) electric log no
 (yes or no)
 (organization running log)

(8) how well bottom plugged plugged


CODED

FEB 20 1973

DRILLERS REMARKS:

If well telescopes please sketch and show depths.

GROUND LEVEL

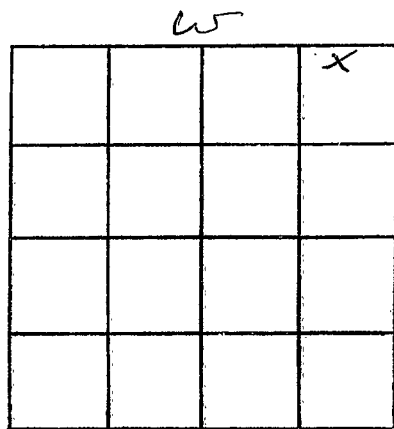

SECTION 35

Please indicate well location X.

ADDITIONAL INFORMATION

If more than one screen,
show locations of each on sketch.