

**MARSHALL**  
**J 82**  
**8-17-72**

MISSISSIPPI  
 BOARD OF WATER COMMISSIONERS  
 416 North State Street  
 Jackson, Mississippi 39201

**CODED**

**WATER WELL DRILLERS LOG**

8-17- 1972 Bob Smith Marshall  
 date well completed firm name county well located


LANDOWNER:	description of formations encountered	from	to
<u>George Powell</u>	<u>clay dirt</u>		<u>12</u>
<u>Warsaw, Miss.</u> (mailing address)	<u>Red sand</u>	<u>12</u>	<u>40</u>
WELL LOCATION:	<u>white sand</u>	<u>40</u>	<u>115</u>
sec. <u>17</u> T. <u>3</u> N. R. <u>4</u> E.			
<u>2 1/2</u> miles <u>East</u> of <u>Warsaw</u>			
(distance) (direction) (nearest town)			
WELL PURPOSE: <u>Home</u> (home, irrigation, municipal, industrial)			
WELL COMPLETION DATA:			
(1) diameter (inches) <u>4</u>			
(2) total depth (feet) <u>115</u>			
(3) static water level (feet) <u>62</u> below above top of ground.			
(4) casing <u>Plastic</u> , <u>115</u> (material) (depth)			
(size) If telescope see back.			
(5) screen <u>20</u> , <u>95</u> (length) (depth to top)			
<u>4</u> , <u>Plastic</u> (size) (material)			
(6) pump <u>3/4</u> , <u>15</u> (HP) (yield gpm)			
<u>Blue</u> (type power)			
(7) electric log <u>no</u> (yes or no)			
(organization running log)			
(8) how well bottom plugged <u>plugged</u>			
DRILLERS REMARKS:			

**CODED**

REG 22 1072

If well telescopes please sketch and show depths.

GROUND LEVEL

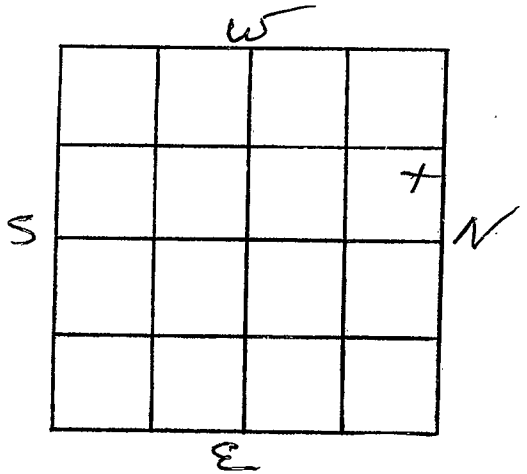

SECTION 17

Please indicate well location X.

**ADDITIONAL INFORMATION**

A series of horizontal lines for additional information.

If more than one screen, show locations of each on sketch.