

MARSHALL

J83

3-28-73

MISSISSIPPI BOARD OF WATER COMMISSIONERS  
416 North State Street  
Jackson, Mississippi 39201

CODED

WATER WELL DRILLERS LOG

3-28  
date well completed

1973 Penn Kent Burges well  
firm name

Marshall  
county well located

LANDOWNER:

Jim Buchanan

description of formations encountered

Clay

from

to

0 20

Holly Springs miss  
(mailing address)

Sand

20 130

WELL LOCATION:

sec. 21 T. 3 N. R. 4 E.  
3 miles South of Victoria  
(distance) (direction) (nearest town)

WELL PURPOSE: (home, irrigation, municipal, industrial)

Domestic

WELL COMPLETION DATA:

- (1) diameter (inches) 4
- (2) total depth (feet) 130 feet
- (3) static water level (feet) 72 1/2 below top of ground.
- (4) casing P.C.S. 130 feet  
(material) (depth)  
(size) If telescope see back.
- (5) screen 7 ft. 12 3/4 feet  
(length) (depth to top)  
4" gravel w/olf  
(size) (material)
- (6) pump 3/4 HP 14  
(HP) (yield gpm)  
(type power)
- (7) electric log flat  
(yes or no)
- (organization running log)
- (8) how well bottom plugged 4" cap.


CODED

DRILLERS REMARKS:

APR 6 1973

If well telescopes please sketch and show depths.

GROUND LEVEL

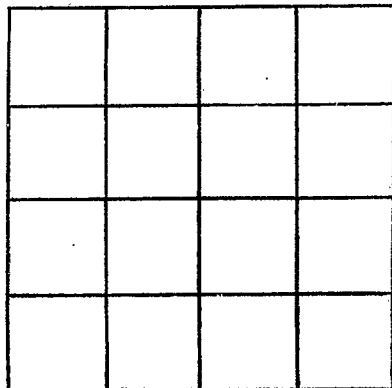

SECTION \_\_\_\_\_

Please indicate well location X.

ADDITIONAL INFORMATION

If more than one screen,  
show locations of each on sketch.