

**MARSHALL**  
 J 86  
 4-13-73

MISSISSIPPI  
 BOARD OF WATER COMMISSIONERS,  
 416 North State Street  
 Jackson, Mississippi 39201

**CODED**

**WATER WELL DRILLERS LOG**

4-13 1973 *Dean Kent Simpson* <sup>well</sup> *Marshall*  
 date well completed firm name county well located


LANDOWNER:	description of formations encountered	from	to
<i>Waters Flayd</i>			
<i>RT 3-Box 139 (Psychology miss)</i> (mailing address)	<i>Sand</i>	<i>30</i>	<i>120</i>
WELL LOCATION: sec. <i>16</i> T. <i>3</i> N. R. <i>4</i> E. <i>2</i> miles <i>South</i> of <i>Vicksburg</i> (distance) (direction) (nearest town)	<i>Clay</i>	<i>120</i>	<i>125</i>
	<i>Sand</i>	<i>125</i>	<i>187</i>
WELL PURPOSE: <i>Domestic</i> (home, irrigation, municipal, industrial)			
WELL COMPLETION DATA:			
(1) diameter (inches) <i>4"</i>			
(2) total depth (feet) <i>187 feet</i>			
(3) static water level (feet) <i>100 ft</i> <sup>below</sup> / <sub>above</sub> top of ground.			
(4) casing <i>pvc</i> <i>187 feet</i> (material) (depth)			
(size) if telescope see back.			
(5) screen <i>7 ft</i> <i>180 feet</i> (length) (depth to top)			
<i>4"</i> <i>Gravel wall</i> (size) (material)			
(6) pump <i>3/4</i> <i>14</i> (HP) (yield gpm)			
(type power)			
(7) electric log <i>Elect.</i> (yes or no)			
(organization running log)			
(8) how well bottom plugged <i>4' cap.</i>			
DRILLERS REMARKS:			

**CODED**

MAY 14 1973

If well telescopes please sketch and show depths.

GROUND LEVEL

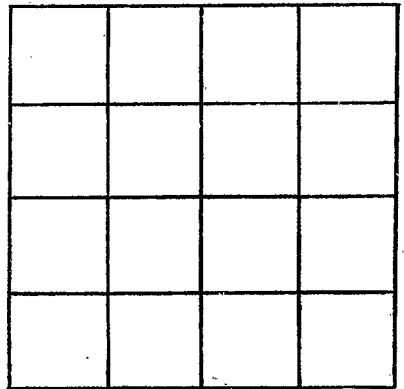

SECTION \_\_\_\_\_

Please indicate well location X.

ADDITIONAL INFORMATION

If more than one screen,  
show locations of each on sketch.