

MARSHALL
J 88
5-22-73

MISSISSIPPI
 BOARD OF WATER COMMISSIONERS
 416 North State Street
 Jackson, Mississippi 39201

CODED

WATER WELL DRILLERS LOG

May 22 1973 Earl Jones Well Co Marshall
 date well completed: firm name: county well located:

LANDOWNER:
Robert Roy
Byhalia Miss. Rt. 1.
 (mailing address)
 WELL LOCATION:
 sec. 4 T. 3 N. R. 4 E.
3/4 miles NW. of Victorio
 (distance) (direction) (nearest town)

description of formations encountered	from	to
Topsoil & clay	0	18
sand	18	38
clay	38	42
sand	42	90
clay	90	92
sand	92	130

WELL PURPOSE: Home
 (home, irrigation, municipal, industrial)

WELL COMPLETION DATA:
 (1) diameter (inches) 4"
 (2) total depth (feet) 130
 (3) static water level (feet) 100 below/above top of ground.
 (4) casing plastic 124'
 (material) (depth)
4" if telescope see back.
 (size)
 (5) screen 6' 124'
 (length) (depth to top)
4" plastic gravel
 (size) (material)
 (6) pump 1/2 18
 (HP) (yield gpm)
Electric
 (type power)
 (7) electric log no
 (yes or no)
 (organization running log)
 (8) how well bottom plugged
plastic cap


CODED

DRILLERS REMARKS:

JUN 14 1973

If well telescopes please sketch and show depths.

GROUND LEVEL

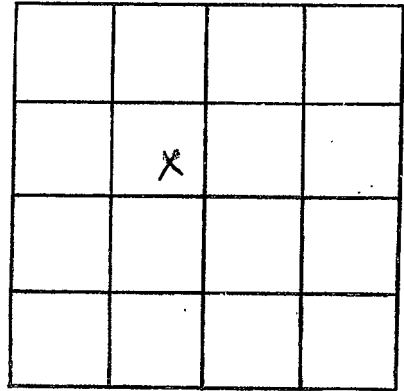

SECTION 4

Please indicate well location X.

ADDITIONAL INFORMATION

If more than one screen,
show locations of each on sketch.