

MARSHALL

J 89

7-23-73

MISSISSIPPI BOARD OF WATER COMMISSIONERS
416 North State Street
Jackson, Mississippi 39201

CODE

WATER WELL DRILLERS LOG

6-25 1973 Deer Creek Pumping well firm name MARSHALL county well located


LANDOWNER:	description of formations encountered	from	to
<u>Bill Clayton</u>			
<u>Holly Springs, Miss</u> (mailing address)	<u>clay</u>	<u>0</u>	<u>20</u>
WELL LOCATION:	<u>sand</u>	<u>20</u>	<u>50</u>
sec. <u>10</u> T. <u>3</u> N R. <u>4</u> E (S) (W)	<u>clay</u>	<u>50</u>	<u>70</u>
<u>1</u> miles <u>NORTH</u> of <u>Victoria</u> (distance) (direction) (nearest town)	<u>sand</u>	<u>70</u>	<u>170</u>
WELL PURPOSE: <u>drinking</u> (home, irrigation, municipal, industrial)			
WELL COMPLETION DATA:			
(1) diameter (inches) <u>4"</u>			
(2) total depth (feet) <u>170 feet</u>			
(3) static water level (feet) <u>100</u> ^{ft} below above top of ground.			
(4) casing <u>PVC</u> <u>170 feet</u> (material) (depth)			
(size) if telescope see back.			
(5) screen <u>7 ft.</u> <u>163 feet</u> (length) (depth to top)			
<u>4"</u> <u>gravel wall</u> (size) (material)			
(6) pump <u>3/4</u> <u>14</u> (HP) (yield gpm)			
(type power)			
(7) electric log <u>Elect.</u> (yes or no)			
(organization running log)			
(8) how well bottom plugged <u>4" cap.</u>			
DRILLERS REMARKS:			

COULD

JUN 27 1973

If well telescopes please sketch and show depths.

GROUND LEVEL

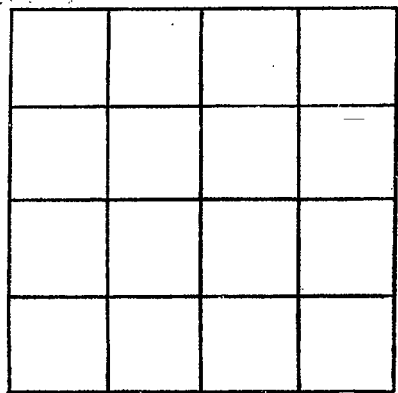

SECTION _____

Please indicate well location X.

ADDITIONAL INFORMATION

A series of horizontal lines providing space for additional information.

If more than one screen, show locations of each on sketch.