

MARSHALL

J93

5-7-73

MISSISSIPPI
 BOARD OF WATER COMMISSIONERS
 416 North State Street
 Jackson, Mississippi 39201

CODED

WATER WELL DRILLERS LOG

5-7-1973
date well completed

Bob Smith
firm name

Marshall
county well located

LANDOWNER:

Robert Newman

Red Bank - Min.
(mailing address)

description of formations encountered

Clay dirt

from

to

to 15

Red sand

15 70

white sand

70 180

WELL LOCATION:

sec. 25 T 3 N R 4 E
 (S) (W)
3 1/2 miles SW of Red Bank
 (distance) (direction) (nearest town)

WELL PURPOSE:

None
(home, irrigation, municipal, industrial)

WELL COMPLETION DATA:

- (1) diameter (inches) 4
- (2) total depth (feet) 180
- (3) static water level (feet) 118 below top of ground.
- (4) casing Plastic, 180
(material) (depth)
- If telescope see back.
(size)
- (5) screen 20, 160
(length) (depth to top)
- 4, Plastic
(size) (material)
- (6) pump 1/2, 10
(HP) (yield gpm)
- E see
(type power)
- (7) electric log no
(yes or no)

(organization running log)

(8) how well bottom plugged plugged

DRILLERS REMARKS:


CODED

SEP 27 1973

MISS. RD. OF
WATER COMM.

If well telescopes please sketch and show depths.

GROUND LEVEL

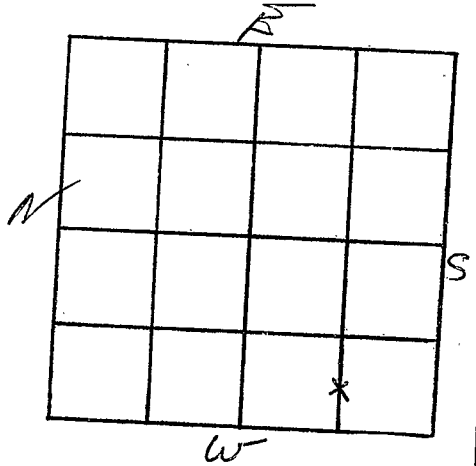

SECTION 25

Please indicate well location X.

ADDITIONAL INFORMATION

If more than one screen, show locations of each on sketch.