

MARSHALL

J 94

8-1-73

MISSISSIPPI BOARD OF WATER COMMISSIONERS  
416 North State Street  
Jackson, Mississippi 39201

CODED

WATER WELL DRILLERS LOG

8-1-1973  
date well completed

Bob Smith  
firm name

Marshall  
county well located

LANDOWNER:

Elmest Paine

Byhalia - Miss  
(mailing address)

description of formations encountered

clay silt

red sand

white sand

from

to

70

14

14

70

70

135

WELL LOCATION:

sec. 8 T. 3 N. R. 4 E. CW

3 1/2 miles SE of Byhalia  
(distance) (direction) (nearest town)

WELL PURPOSE:

Store  
(home, irrigation, municipal, industrial)

WELL COMPLETION DATA:

(1) diameter (inches) 4

(2) total depth (feet) 135

(3) static water level (feet) 20 below top of ground.

(4) casing Plastic 135  
(material) (depth)

if telescope see back.  
(size)

(5) screen 20 115  
(length) (depth to top)

4 Plastic  
(size) (material)

(6) pump 1/3 10  
(HP) (yield gpm)

E see  
(type power)

(7) electric log no  
(yes or no)

(organization running log)

(8) how well bottom plugged plugged


DRILLERS REMARKS:

CODED

QED 27 1973

If well telescopes please sketch and show depths.

GROUND LEVEL

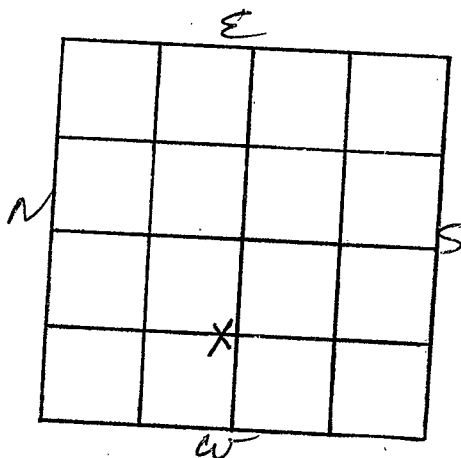

SECTION 8

Please indicate well location X.

ADDITIONAL INFORMATION

If more than one screen, show locations of each on sketch.