

**MARSHALL**  
**J 99**  
**12-4-73**

MISSISSIPPI  
 BOARD OF WATER COMMISSIONERS  
 416 North State Street  
 Jackson, Mississippi 39201

**CODED**

**WATER WELL DRILLERS LOG**

Dec 4 1973 Earl Jones Well Co Marshall  
 date well completed firm name county well located

**LANDOWNER:**

Willie S. Mayes

Victoria Miss.  
 (mailing address)

**WELL LOCATION:**

sec. 9 T 3 N R 4 E  
 S W  
 3/4 miles SW. of Victoria  
 (distance) (direction) (nearest town)

**WELL PURPOSE:** Home  
 (home, irrigation, municipal, industrial)

**WELL COMPLETION DATA:**

- (1) diameter (inches) 4
  - (2) total depth (feet) 154
  - (3) static water level (feet) 110 below top of ground.
  - (4) casing plastic, 148,  
 (material) (depth)  
4"  
 (size) if telescope see back.
  - (5) screen 6', 148  
 (length) (depth to top)  
4", plastic gravel  
 (size) (material)
  - (6) pump 1/2, 15  
 (HP) (yield gpm)  
Electric  
 (type power)
  - (7) electric log Yes  
 (yes or no)
- (organization running log)
- (8) how well bottom plugged  
plastic cage

**description of formations encountered**

from to

Topsoil and clay	0	18
Sand	18	50
clay	50	54
sand	54	105
clay	105	135
sand - 1	135	154


**CODED**

**DRILLERS REMARKS:**

REC 20 1312

If well telescopes please sketch and show depths.

GROUND LEVEL

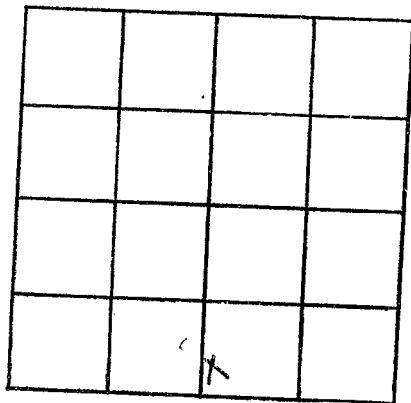

SECTION 9

Please indicate well location X.

ADDITIONAL INFORMATION

If more than one screen,  
show locations of each on sketch.