

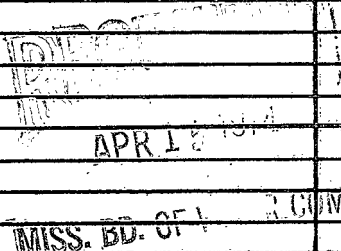
**MARSHALL**  
**J 101**  
**3-19-74**

MISSISSIPPI  
 BOARD OF WATER COMMISSIONERS  
 416 North State Street  
 Jackson, Mississippi 39201

**CODED**

**WATER WELL DRILLERS LOG**

March 19 1974 Earl Jones Well Co. Marshall  
 date well completed firm name county well located

LANDOWNER:	description of formations encountered	from	to
<u>Fred Hensley</u>	<u>Topsoil + clay</u>	<u>0</u>	<u>12 1/2</u>
<u>Red Bank, Miss RT 1</u> (mailing address)	<u>sand</u>	<u>14</u>	<u>8 1/2</u>
<b>WELL LOCATION:</b>	<u>clay</u>	<u>28</u>	<u>2 1/2</u>
sec. <u>3</u> T. <u>3</u> N. R. <u>4</u> E <u>3/4</u> miles <u>apt</u> of <u>Victoria</u> (distance) (direction) (nearest town)	<u>sand</u>	<u>28</u>	<u>1 1/2</u>
<b>WELL PURPOSE:</b> <u>Home</u> (home, irrigation, municipal, industrial)	<b>CODED</b>		
<b>WELL COMPLETION DATA:</b>			
(1) diameter (inches) <u>4"</u>			
(2) total depth (feet) <u>140'</u>			
(3) static water level (feet) <u>95'</u> below top of ground.			
(4) casing <u>plastic</u> , <u>134'</u> (material) (depth)			
_____ if telescope see back. (size)			
(5) screen <u>6'</u> , <u>134'</u> (length) (depth to top)			
<u>4"</u> , <u>plastic gravel</u> (size) (material)			
(6) pump <u>1/2</u> , <u>12</u> (HP) (yield gpm)			
<u>Electric</u> (type power)			
(7) electric log <u>no</u> (yes or no)			
_____ (organization running log)			
(8) how well bottom plugged <u>plastic cap</u>			
<b>DRILLERS REMARKS:</b>			

If well telescopes please sketch and show depths.

GROUND LEVEL

		X	

SECTION 3

Please indicate well location X.

ADDITIONAL INFORMATION

If more than one screen,  
show locations of each on sketch.